


932 BANCROFT AVE KITCHEN REMODEL

ALL CONSTRUCTION SHALL BE IN STRICT ACCORDANCE WITH THE FOLLOWING CODES AND STANDARDS:
 CALIFORNIA BUILDING CODE, 2019 EDITION
 CALIFORNIA RESIDENTIAL CODE, 2019 EDITION
 CALIFORNIA PLUMBING CODE, 2019 EDITION
 CALIFORNIA MECHANICAL CODE, 2019 EDITION
 CALIFORNIA ELECTRICAL CODE, 2019 EDITION
 2019 CALIFORNIA REFERENCED STANDARDS CODE
 2019 CALIFORNIA ENERGY CODE
 2019 CALIFORNIA GREEN BUILDING STANDARDS CODE
 CITY OF SAN LEANDRO MUNICIPAL CODE
 COUNTY OF ALAMEDA CODES AND ORDINANCES


DESCRIPTION OF WORK:
 REPLACE KITCHEN CABINETS, SINK, SINK FIXTURE, APPLIANCES, & COUNTERTOPS

CONTRACTOR MUST RECYCLE AND/OR SALVAGE FOR REUSE A MINIMUM OF 65 PERCENT OF THE NON-HAZARDOUS CONSTRUCTION AND DEMOLITION WASTE IN ACCORDANCE WITH SECTION 4.408.1, ON SHEET G1.0, OR MEET A MORE STRINGENT CONSTRUCTION AND DEMOLITION WASTE MANAGEMENT ORDINANCE PERSCRIBED BY THE CITY OF SAN LEANDRO OR COUNTY OF ALAMEDA. SEE THE FOLLOWING LINK FOR INSTRUCTIONS ON HOW TO COMPLY:
[HTTPS://SANLEANDRO.ORG/DEPTS/PW/ES/CONSTRUCTION.ASP](https://sanleandro.org/depts/pw/es/construction.asp)


Revision History	
	AS-BUILT
	PRELIMINARY DESIGN
	DESIGN
	PERMIT SET
▲	PLAN REVIEW COMMENTS
▲	PLAN REVIEW COMMENTS

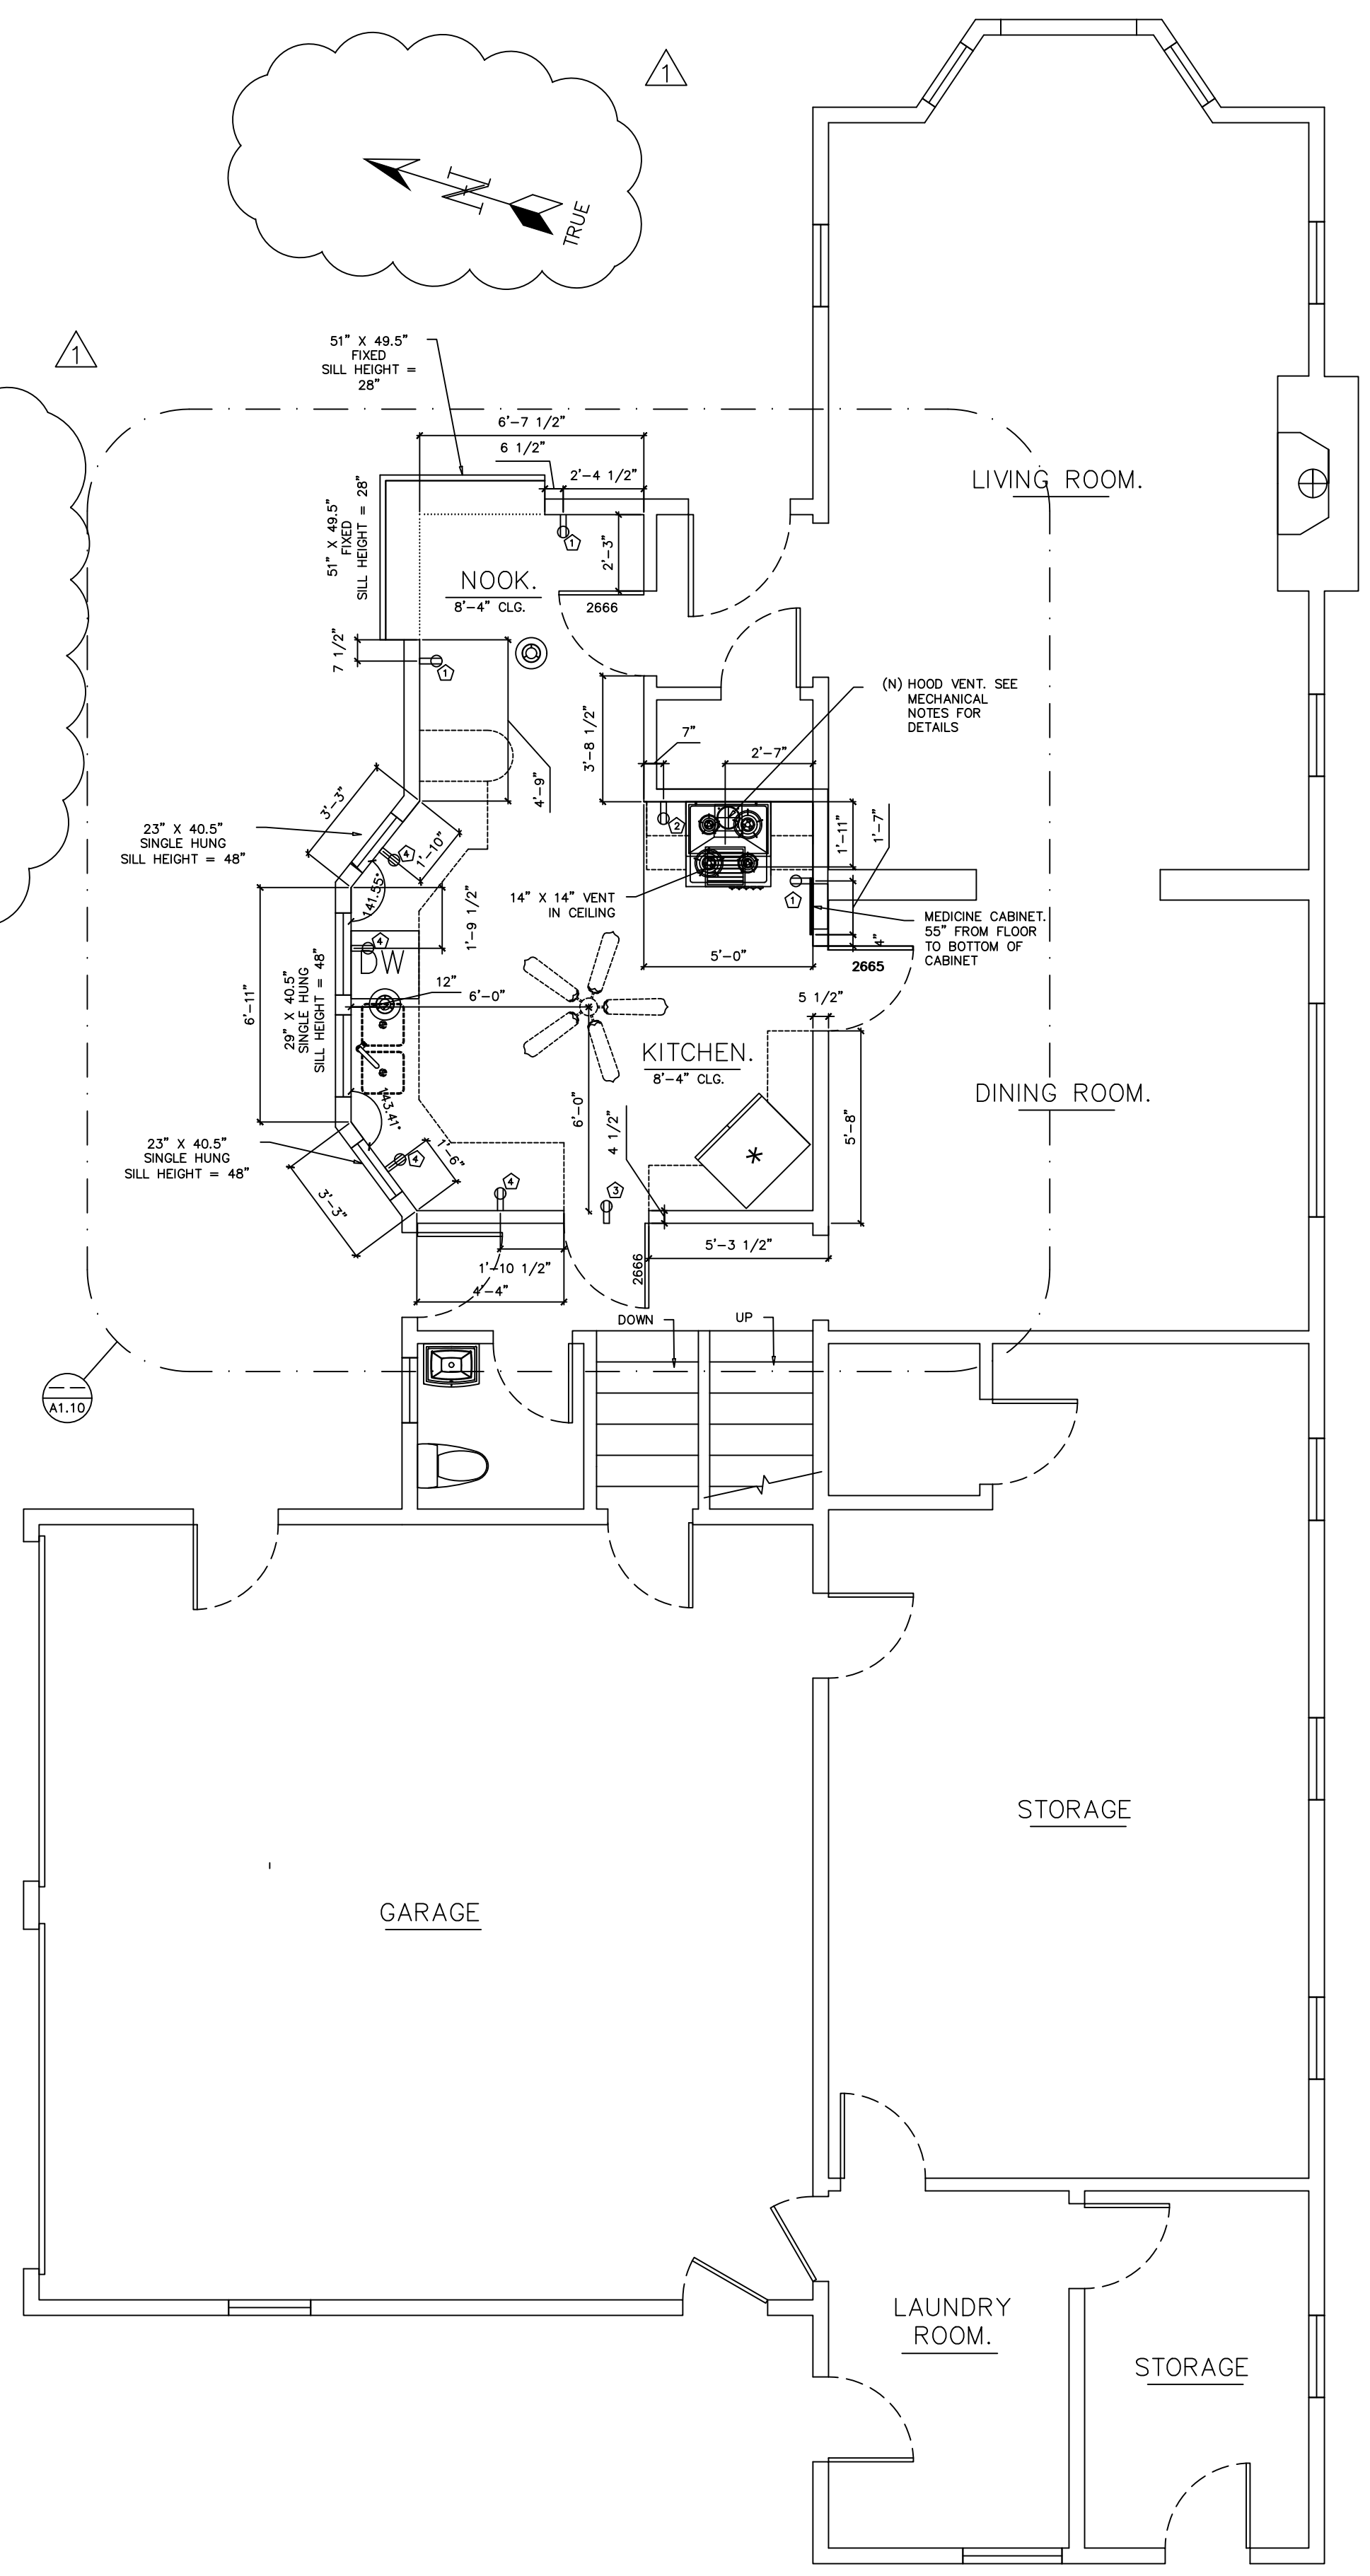


(E) FLOOR PLAN
 SCALE: 1/4" = 1'-0"

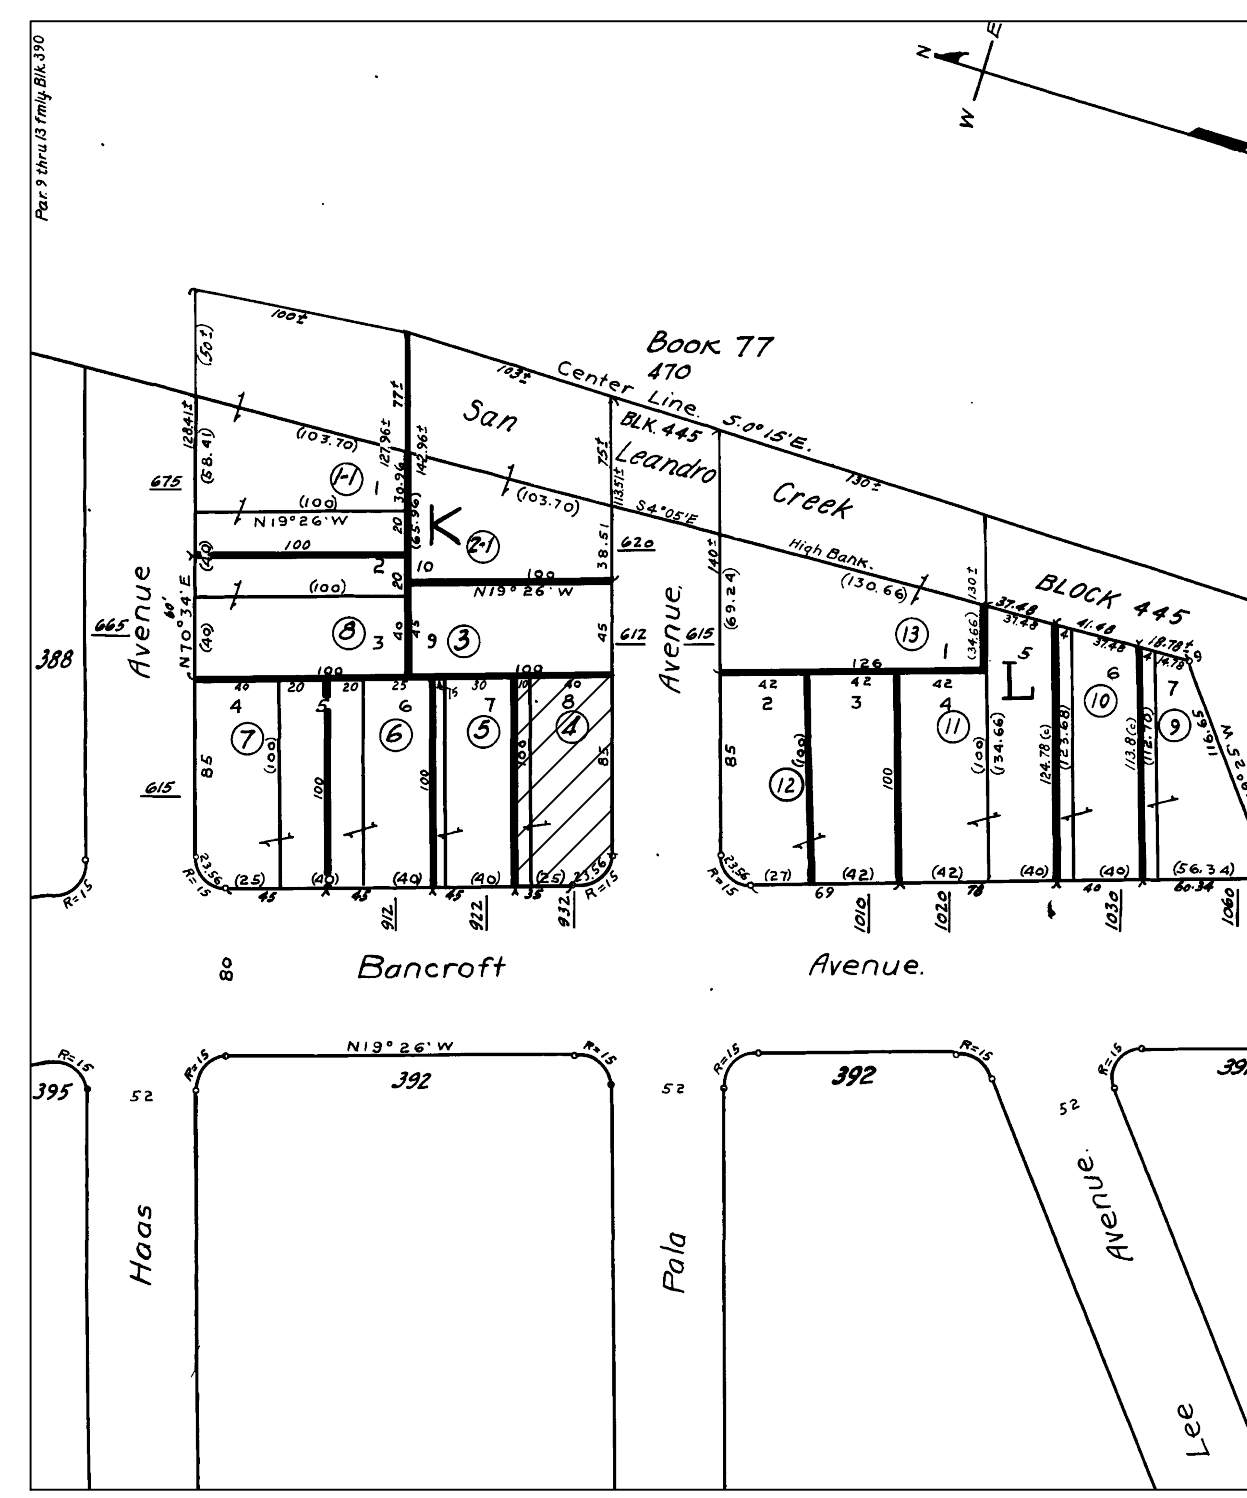

ASSESSORS PARCEL MAP

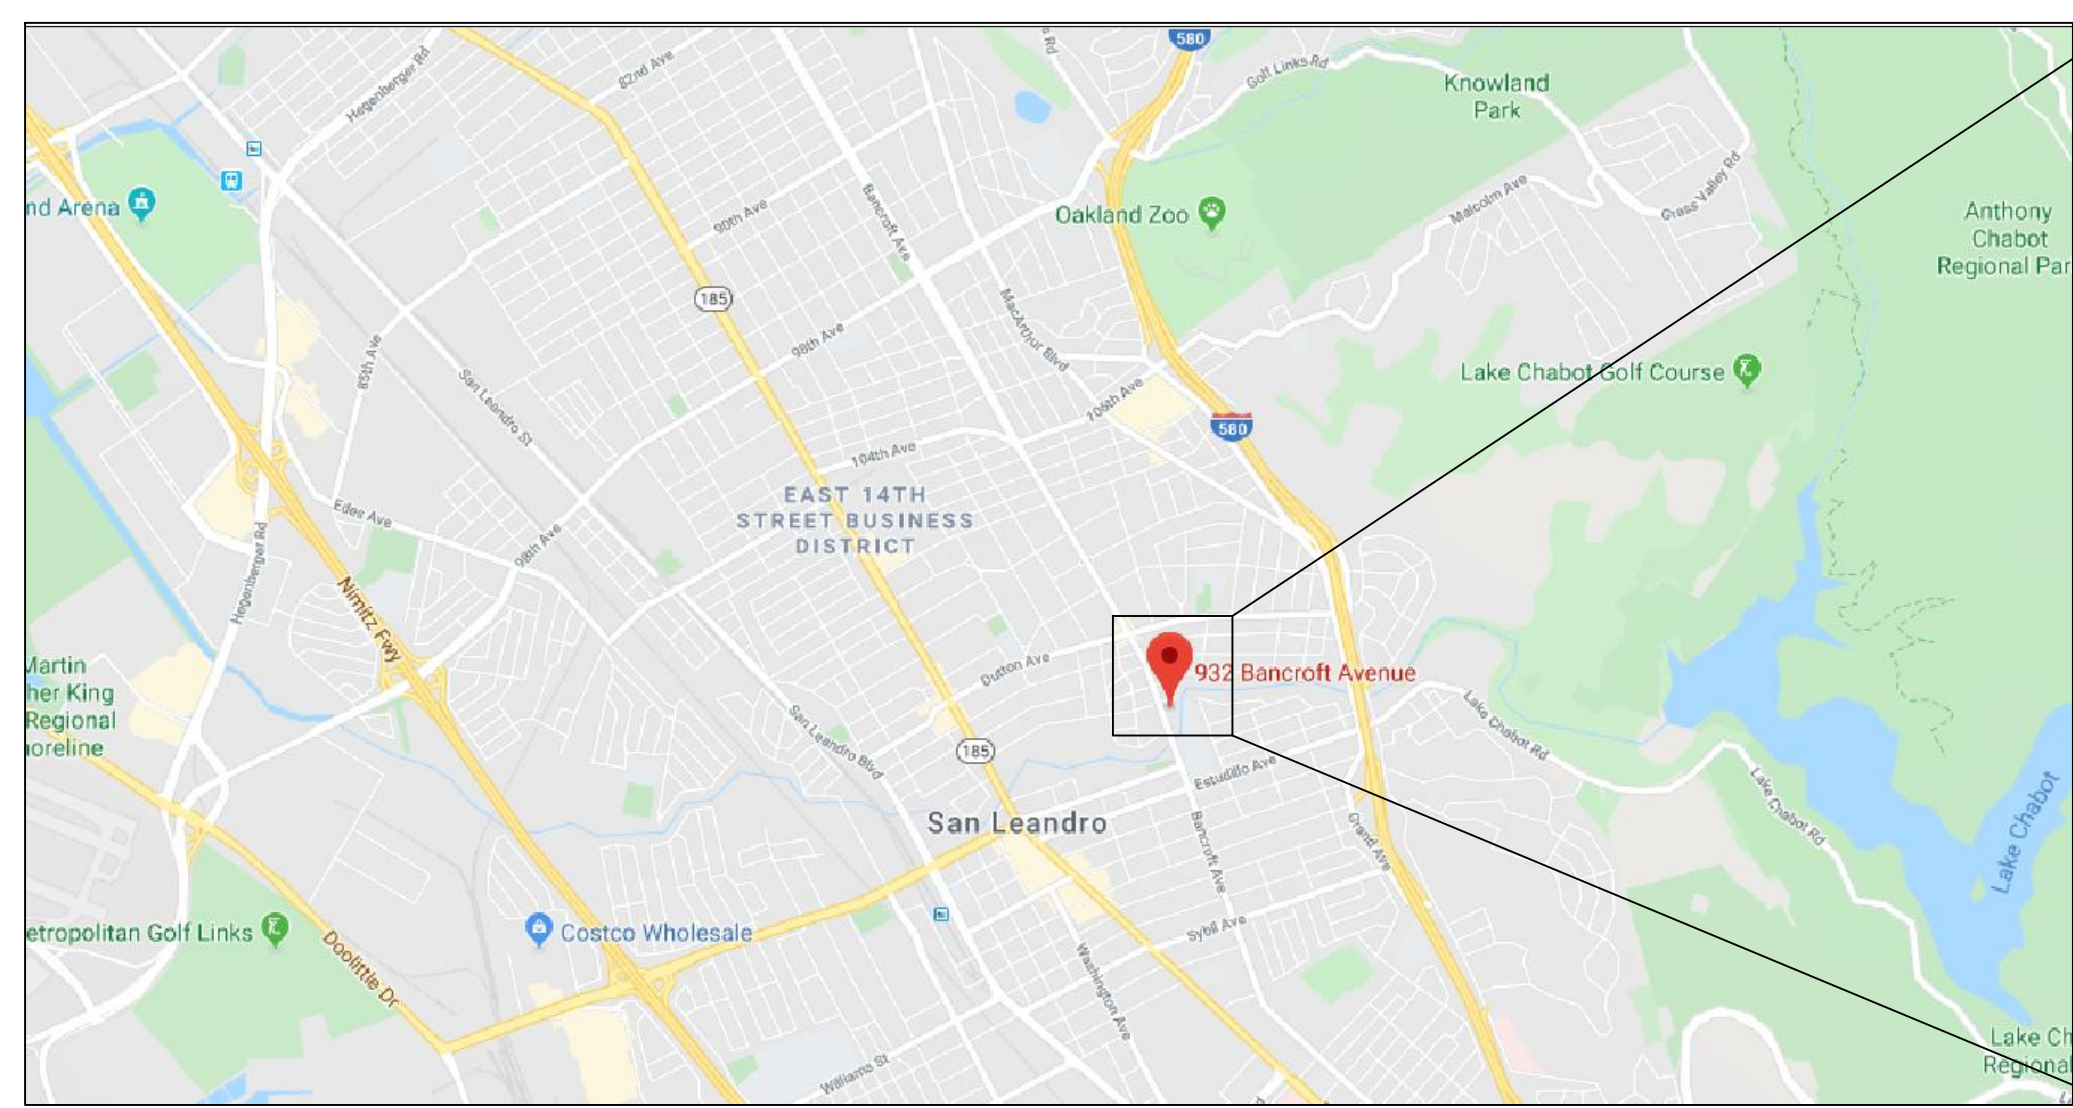

VICINITY MAP

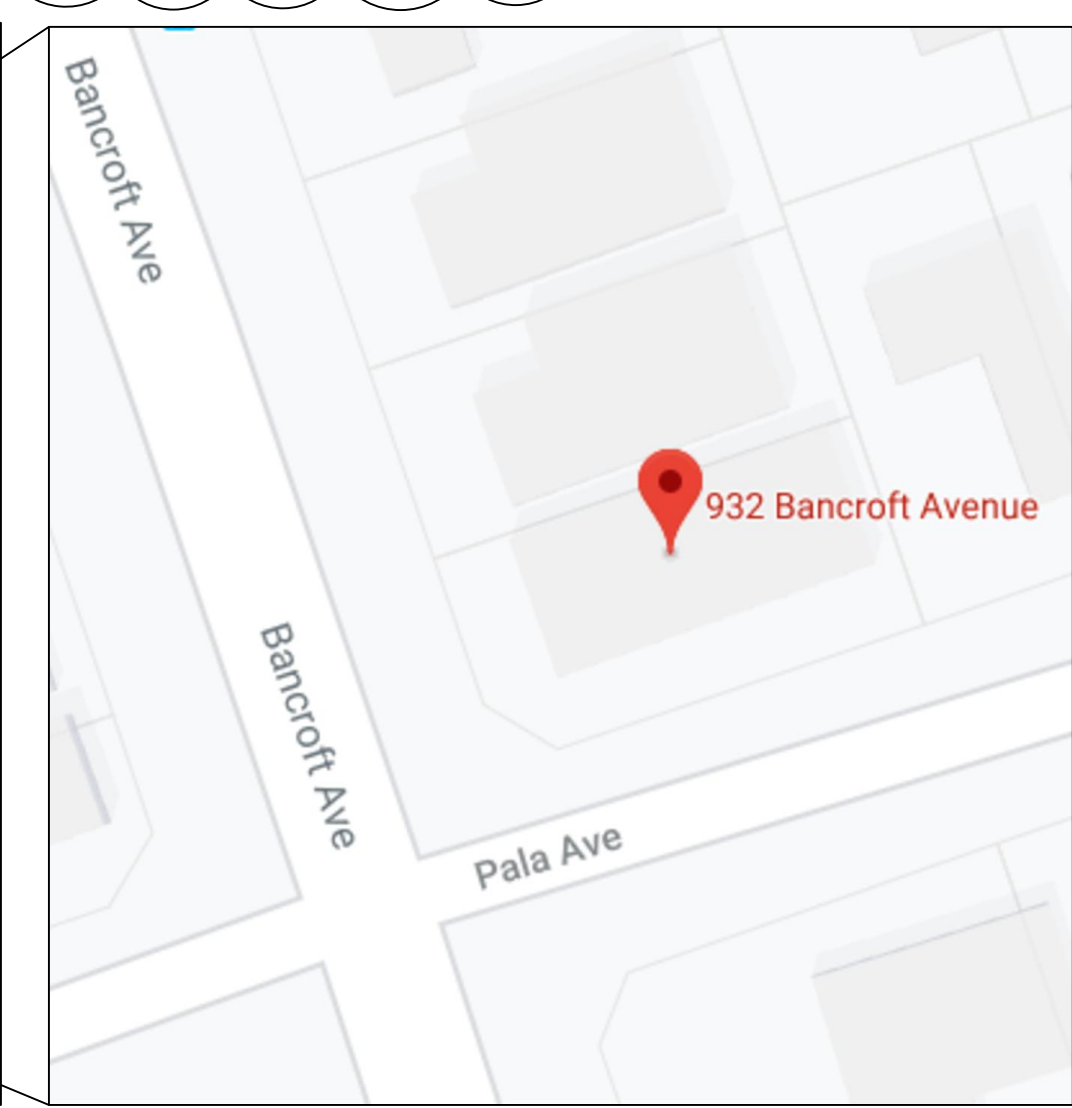

LOCAL MAP

PROJECT DATA:	
COUNTY: ALAMEDA	
APN#: 076-389-004	
YEAR BUILT: 1938	
ZONING: RS	
OCCUPANCY: A-3	
CLIMATE ZONE: 3	
TYPE OF CONSTRUCTION: V-B	
SEISMIC CATEGORY "D"	
SPRINKLERS: NO	
STORIES: 1.5	
BEDROOMS: (E) 3 (N) 3	
BATHROOMS: (E) 2 (N) 2	
(E) RESIDENCE:	2,467 SQ FT
RESIDENCE ADDITION:	0 SQ FT
(N) LIVING AREA:	2,467 SQ FT
(E) GARAGE:	520 SQ FT
GARAGE ADDITION:	0 SQ FT
(N) GARAGE AREA:	520 SQ FT
(E) BUILDING TOTAL S.F.:	2,467 SQ FT
(N) BUILDING TOTAL S.F.:	2,467 SQ FT
LOT SF:	5,000 SQ FT
SHEET INDEX:	
A0.1	COVER, PROJECT DATA, INDEX
A0.2	CODE & CONSTRUCTION NOTES
A1.10	ENLARGED FLOOR PLAN & DEMOLITION PLAN
P1.1	PLUMBING PLAN
A1.80	CABINET PLAN VIEW
G1.0	CAL GREEN REQUIREMENTS
GT.1	CAL GREEN REQUIREMENTS
G1.2	CAL GREEN CHECKLIST

REMODEL & ADDITION	OWNER:
--------------------	--------

Drawing By:
Chris Klimen
klimen@att.net
PH: 510.928.1359

Peter Christopher Klimen
 DIGITALLY SIGNED BY PETER CHRISTOPHER KLIMEN
 EMAIL: KLIMEN@ATT.NET DATE: 00/00/00

SITE DATA
 SHEET INDEX

A0.1

ABBREVIATIONS

&	AND	F.B.	FLAT BAR	QT	QUARRY TILE
?	ANGLE	F.H.W.S.	FLAT HEAD WOOD SCREW	R.W.L.	RAIN WATER LEADER
⊙	AT	FL.	FLOOR	RWD.	REDWOOD
?	CENTERLINE	F.D.	FLOOR DRAIN	RGRTR	REGISTER
(E)	DIAMETER	F.J.	FLOOR JOISTS	REINFC	REINFORCE
(N)	EXISTING	FLUOR.	FLUORESCING	REF.	REFERENCE
⊥	NEW	FT.	FOOT OR FEET	REFG.	REFRIGERATOR
#	PERPENDICULAR	FTG.	FOOTING	REQ.	REQUIRED
ABV.	POUND	FAU.	FORCED AIR UNIT	RESIL.	RESILIENT
AB	ABOVE	FDN.	FOUNDATION	REDWD.	REDWOOD
ACOUS.	ANCHOR BOLT	FRAM'G	FRAMING	REV	REVERSE
ADJ.	ACOUSTICAL	FLS./FS	FULL SIZE	R.	RISER / RADIUS
ADJ.	AREA DRAIN	FURR.	FURRING	RM.	ROOM
AFF	ADJUSTABLE	FUT.	FUTURE	R.O.	ROUGH OPENING
AGGR	ABOVE FINISH FLOOR	GALV.	GALVANIZED	S.N.D.	SANITARY NAPKIN
AL./ALUM.	AGGREGATE	G.I.	GALVANIZED IRON	S.N.R.	DISPENSER
APPROX.	ALUMINUM	G.S.M.	GALVANIZED SHEET METAL	SCH.D.	SCHEDULE
ARCH.	APPROXIMATE	GA.	GAUGE	S.C.D.	SEAT COVER DISPENSER
ARCH'L	ARCHITECT	GL.	GLASS	SECT.	SECTION
ASPH.	ARCHITECTURAL	G.B.	GRAB BAR	S.C.E.D.	SEE CIVIL ENGINEER
AWG.	ASPHALT	GR.	GRADE	S.E.D.	DRAWINGS
	AWNING	GND.	GROUND	S.L.D.	SEE LANDSCAPE DRAWINGS
BM.	BEAM	GNY.	GROUND FAULT INTERRUPTER	S.M.D.	SEE MECHANICAL DRAWINGS
BITUM.	BITUMINOUS	GYP.	GYPSPUM	S.P.D.	SEE PLUMBING DRAWINGS
BLK.	BLOCK	GYP.BD.	GYPSPUM BOARD	S.S.D.	SEE STRUCTURAL DRAWINGS
BLK.G.	BLOCKING	H/C	HANDICAP	S.S.X.	SERVICE SINK
BD.	BOARD	H.D.C.P.	HANDICAP/HANDICAPPED	SW.	SHEAR WALL
BLT.	BOLT	HDWE.	HARDWARE	SHT.	SHIRT
BOT.	BOTTOM	HDWD.	HARDWOOD	SHR.	SHOWER
BLDG.	BUILDING	HGT./HT.	HEIGHT	SHR.	SHOWER
		H.C.	HOLLOW CORE	SH.	SIMILAR
CAB.	CABINET	H.M.	HOLLOW METAL	SH	SINGLE HUNG/SHELF
C.O.	CASED OPENING	HORIZ.	HORIZONTAL	S.	SINK
C.B.	CATCH BASIN	H.B.	HOSE BIB	SKYLT	SKYLIGHT
CPT	CARPET	H.P.	HIGH POINT	SL.	SLIDING / SLOPE
CAS	CASEMENT	H.R.	HOUR	SD.	SMOKE DETECTOR
CHLK.	CHAIN LINK	H.V.A.C.	HEATING, VENTING & AIR CONDITIONING	S.D.	SOAP DISPENSER
C.I.	CAST IRON	I.D.	INSIDE DIAMETER	S.C.	SOLID CORE
CLKG.	CAULKING	INT.	INTERIOR	S.	SOUTH
C.J.	CEILING JOISTS	I.C.B.O.	INTERNATIONAL CONFERENCE OF BUILDING OFFICIALS	SP	SPACE
CLG.	CEILING	JAN.	JANITOR	SPEC.	SPECIFICATION
CEM.	CEMENT	JT.	JOINT	SQ.	SQUARE
CTR.	CENTER	K.D.	KILN DRIED	SQ.FT.	SQUARE FOOT
CER.	CERAMIC	KIT.	KITCHEN	SQ.IN.	SQUARE INCH
C.T.	CERAMIC TILE	LAB	LABORATORY	SST	STAINLESS STEEL
CLR.	CLEAR	LAM	LAMINATE	STD.	STANDARD
CLO.	CLOSET	LAV.	LAVATORY	STA.	STATION
CMU	CONCRETE MASONRY UNIT	L.T.	LIGHT	STL.	STEEL
COL.	COLUMN	LKR.	LOCKER	STOR.	STORAGE
CVT.	COMPOSITION VINYL TILE	M.B.	MACHINE BOLT	STR.	STRUCTURAL
CONC/C.	CONCRETE	MFR.	MANUFACTURER	STRUC	STRUCTURE
CONN.	CONNECTION	MFG	MANUFACTURING	SUSP.	SUSPENDED
CONST.	CONSTRUCTION	MAX.	MAXIMUM	SYM.	SYMMETRICAL
CONT.	CONTINUOUS	MECH.	MECHANICAL	TEL.	TELEPHONE
CORR.	CORRIDOR	M.C.	MEDICINE CABINET	T.V.	TELEVISION
CG	CORNER GAURD	MEMB.	MEMBRANE	TEMP.	TEMPERED/TEMPORARY
CTSK	COUNTERSINK	MET.	METAL	TERR.	TERRAZZO
		MH.	MAN HOLE	THK./TK	THICK
DEPT.	DEPARTMENT	MIN.	MINIMUM	TL	TOILET PAPER DISPENSER
DET.	DETAIL	MIR.	MIRROR	T.G.	TONGUE AND GROOVE
D.F.	DOUGLAS FIR	MISC.	MISCELLANEOUS	T.O.C.	TOP OF CURB
D/F	DRINKING FOUNTAIN	M.O.	MASONRY OPENING	T.O.P.	TOP OF PAVEMENT
DIA.	DIAMETER	MOUNT.	MOUNTED	T.O.S.	TOP OF SUBFLOOR/SLAB
DIM.	DIMENSION	MUL.	MULLION	T.O.SHTG.	TOP OF SHEATHING
DISP.	DISPENSER	N.	NORTH	T.O.P.L.	TOP OF PLATE
DR.	DOOR	NOM.	NOMINAL	T.O.W.	TOP OF WALL/WINDOW
D.O.	DOOR OPENING	N.I.C.	NOT IN CONTRACT	T.B.	TOWEL BAR
DBL	DOUBLE	N.T.S.	NOT TO SCALE	TREAD	TREAD
DH.	DOUBLE HUNG	NO or #	NO OR #	TYP.	TYPICAL
DN.	DOWN	OBS.	OBSOLETE	U.L.	UNDERWRITERS LABORATORY
DS.	DOWN SPOUT	O.F.E.	OWNER FURNISHED EQUIPMENT	UNF.	UNFINISHED
D.S.P.	DRY STAND PIPE	OFF.	OFFICE	UNC.	UNIFORM BUILDING CODE W/ CALIFORNIA AMENDMENTS
DWR.	DRAWER	OPNG.	OPENING	UR.	UNLESS OTHERWISE NOTED
DWG'S	DRAWINGS	OPP.	OPPOSITE		URINAL
		O.H.	OPPOSITE HAND	V.I.F.	VERIFY IN FIELD
E.	EAST	O.D.	OUTSIDE DIAMETER (dia)	VERT.	VERTICAL
E.A.	EACH	O/O	OVER	V.G.	VERTICAL GRAIN
E.I.F.S.	EXTERIOR INSULATED FINISH SYSTEM	O.A.	OVERALL	VEST.	VESTIBULE
		OH.	OVER HANG/OVERHEAD	VNL./V	VINYL
E.J.	ELECTRICAL	PR	PAIR	VCT	VINYL COMPOSITION TILE
ELEC.	ELECTRICAL PANELBOARD	PTD	PAINTED	W.	WEST/WAX
EP.	ELEVATION	P.NL	PANEL	WCST	WATER CLOSET
EL./ELEV	ELEVATOR	P.T.D.	PAPER TOWEL DISPENSER	W.C.	WATER HEATER
EMER.	EMERGENCY	P.T.D/R	PAPER TOWEL DISPENSER AND RECEPTACLE COMBO	WT.	WEIGHT
ENCL.	ENCLOSURE	PTR.	PARTITION	W/	WITH
EQ.	EQUAL	PTN	PAPER TOWEL RECEPTACLE	W./O.	WITHOUT
EQUPT.	EQUIPMENT	P.D.	PLASTER	WD.	WOOD
E.W.C.	ELECTRICAL WATER COOLER	PLAS.	PLASTIC LAMINATE		
EXST.	EXISTING	P.LAM.	PLATE		
EXP.	EXPANSION	PL.	PLUMBING		
EXPO.	EXPOSED	PLYWD./PLY	PLYWOOD		
EXT.	EXTERIOR	PT.	POINT/PRESSURE TREATED		
		P.I.P	POURED IN PLACE		
F.C.	FACE OF CONCRETE	PRFAB	PREFABRICATED		
F.B.	FACE OF CONCRETE BLOCK	P/L	PROPERTY LINE		
F.O.M.	FACE OF MULLION	PRCST.	PRE-CAST		
F.D.	FLOOR DRAIN				
F.O.F.	FACE OF FINISH				
F.O.S.	FACE OF STUDS				
F.F.	FALSE FRONT/FINISH FLOOR				
FIN.	FINISH				
FS	FINISH GRADE				
F.A.	FIRE ALARM				
F.E.	FIRE EXTINGUISHER				
F.E.C.	FIRE EXTINGUISHER CAB.				
F.H.C.	FIRE HOSE CABINET				
FRF.	FIREPROOF				
FIX.	FIXED				
FLASH.	FLASHING				

GENERAL NOTES:

- THESE PLANS ARE FOR GENERAL CONSTRUCTION PURPOSES ONLY. THEY ARE NOT EXHAUSTIVELY DETAILED NOR FULLY SPECIFIED. IT IS THE RESPONSIBILITY OF THE CONTRACTOR TO VERIFY DIMENSIONS, CONDITIONS, MATERIALS, EQUIPMENT, SELECTIONS, AND TITLE 24 COMPLIANCE.
- DO NOT SCALE THE DRAWINGS. DIMENSIONS ARE TO FACE OF FINISH AND ACTUAL DOOR OPENING WIDTH UNLESS OTHERWISE NOTED (U.O.N.). ALL DIMENSIONS NOTED "CLEAR" OR "CLR" ARE FOR EQUIPMENT CLEARANCES AND MUST BE STRICTLY MAINTAINED. ALL DIMENSIONS NOTED "VERIFY" OR V. I. F. ARE TO BE CHECKED BY CONTRACTOR PRIOR TO AND DURING CONSTRUCTION. DIMENSIONS TAKE PRECEDENCE OVER SCALE OF THE DRAWING; DO NOT SCALE DRAWINGS.
- MANUFACTURER'S MATERIALS, EQUIPMENT, ETC., SHALL BE INSTALLED PER MANUFACTURER'S RECOMMENDATIONS AND INSTRUCTIONS (U.O.N.). THE CONTRACTOR ACKNOWLEDGES THAT THE DRAFTER SHALL NOT SUPERVISE, DIRECT, OR HAVE CONTROL OVER THE WORK NOR SHALL THE DRAFTER HAVE ANY RESPONSIBILITY FOR THE CONSTRUCTION MEANS, METHODS, TECHNIQUES, SEQUENCES, OR PROCEDURES SELECTED BY THE CONTRACTOR NOR THE CONTRACTOR'S SAFETY PRECAUTIONS OR PROGRAMS IN CONNECTION WITH THE WORK. THESE RIGHTS AND RESPONSIBILITIES ARE SOLELY THOSE OF THE CONTRACTOR IN ACCORDANCE WITH THESE CONTRACT DOCUMENTS.
- INSTALLATION INSTRUCTIONS FOR ALL LISTED EQUIPMENT SHALL BE PROVIDED TO THE FIELD INSPECTOR AT TIME OF INSPECTION.
- ALL NEW CONSTRUCTION TO BLEND/MATCH EXISTING.
- PROVIDE FIRE DEPARTMENT ACCESS AT ALL TIMES DURING CONSTRUCTION.
- CONTRACTOR IS TO PROVIDE AND INSTALL ALL WORK SHOWN ON DRAWINGS, SUBJECT TO THE LIMITATIONS OF SCOPE OF THE BASE BID, LISTED ABOVE. THE CONTRACTOR SHALL PROVIDE MISCELLANEOUS FASTENERS, BLOCKING AND SEALANTS INCIDENTAL TO COMPLETE THE CONTRACTED WORK. THIS SHALL INCLUDE SUPPLYING AND INSTALLING NECESSARY BACKING INSIDE WALLS FOR THE INSTALLATION OF WALL HANGING ACCESSORIES WHERE INDICATED. ALL WORK SHALL BE INSTALLED AS SHOWN ON DRAWINGS, PLUMB, AND LEVEL, TRUE TO LINE AND SECURELY FASTENED OR ANCHORED.
- CONTRACTOR SHALL REVIEW ALL PLANS AND SPECIFICATIONS TO COORDINATE WITH EXISTING BUILDING CONDITIONS. IT IS THE RESPONSIBILITY OF THE CONTRACTOR TO BRING ANY FIELD OBSERVED CODE VIOLATIONS, OR INCORRECT EXISTING CONSTRUCTION INCLUDING APPARENT CONFLICTS BETWEEN THE EXISTING CONSTRUCTION AND THE CONTRACT DRAWINGS TO THE IMMEDIATE ATTENTION OF THE DESIGNER. DO NOT SCALE DRAWINGS, CONTACT DESIGNER FOR CLARIFICATION OF DIMENSIONS.
- CONTRACTOR SHALL MAKE EVERY REASONABLE EFFORT TO PROTECT THE POSSESSIONS OF THE OWNER THAT REMAIN IN OR ADJACENT TO THE WORK FROM LOSS OR DAMAGE. ANY PORTION OF THE PROPERTY DAMAGED BY THE CONTRACTOR OR SUBCONTRACTOR DURING THE COURSE OF THE WORK MUST BE REPAIRED AT NO ADDITIONAL COST TO THE OWNER. THE TERM "DAMAGES" SHALL INCLUDE, BUT NOT BE LIMITED TO ANY DAMAGE CAUSED BY CONTRACT OPERATION OR WORKERS DURING CONSTRUCTION TO THE OWNER'S RESIDENCE, FURNISHINGS, CLOTHING, FENCES, ADJOINING PROPERTIES OR TO PUBLIC SPACES.

PLUMBING NOTES:

- KITCHEN SINK FAUCETS SHALL HAVE A MAXIMUM FLOW RATE OF 1.8 GPM.
- PROVIDE 1-1/2" DRAIN LINE MINIMUM FROM KITCHEN. CPC 420.3
- PROVIDE A LISTED AIR GAP FOR DISHWASHER. CPC 414.3
- MINIMUM OF 1/4" PER FOOT (2%) SLOPE FOR ALL HORIZONTAL DRAINAGE PIPING.
- SEISMIC STRAPPING FOR HOT WATER HEATER REQUIRED PER CPC SECTION 508.2.
- THE HOT WATER HEATER TEMPERATURE/PRESSURE RELIEF VALVE SHALL HAVE ATTACHED TO IT A PIPE WHICH WILL RUN OUTSIDE THE BUILDING WITH THE END OF THE PIPE BETWEEN 6 & 24 INCHES ABOVE GRADE & POINTED DOWN.
- ALL NEW GAS PIPING SHALL BE SIZED TO SUPPLY SUFFICIENT GAS TO THE APPLIANCES. THE GAS PIPING SHALL BE TESTED WITH 10 LBS. OF PRESSURE FOR A MINIMUM OF 15 MINUTES.
- HOT WATER PIPING 3/8" AND GREATER SERVING A KITCHEN SHALL BE INSULATED WITH MINIMUM 1" WALL THICKNESS INSULATION.
- ALL OVEN AND STOVE GAS VALVES SHALL BE READILY ACCESSIBLE AND BE WITHIN 3'-0" OF THE APPLIANCE. CONNECTORS MAY NOT BE CONCEALED OR PASS THROUGH ANY FLOOR, WALL PARTITION, CEILING, OR APPLIANCE HOUSING CABINET.
- A 2" ACCESSIBLE PLUMBING CLEANOUT UNDER THE SINK SHALL BE REQUIRED.
- AN AIR GAP ABOVE THE SINK RIM SHALL BE INSTALLED BETWEEN THE DISHWASHER DRAINPIPE AND THE GARBAGE DISPOSAL INLET.

MECHANICAL NOTES:

- PER CMC, SECTION 502.2.1, POINT OF EXHAUST VENT MUST BE A MINIMUM OF 3'-0" FROM A PROPERTY LINE OR OPENINGS INTO THE BUILDINGS SUCH AS DOORS, WINDOWS, OPENING SKYLIGHTS, ATTIC VENTS & 10'-FEET FROM A FORCED AIR INLET.
- PER CMC, SECTION 504.1.1, BACK DRAFT DAMPER ARE REQUIRED ON VENTILATION SYSTEMS EXHAUSTING TO THE EXTERIOR.
- PROVIDE EXHAUST HOOD OVER RANGE/ COOKTOP, 100 CFM MINIMUM AND IT SHALL TERMINATE OUTSIDE.
- A VERTICAL MINIMUM CLEARANCE OF 30" IS REQUIRED ABOVE A RANGE TO COMBUSTIBLES MATERIALS, AND A MINIMUM VERTICAL CLEARANCE OF 24" ABOVE THE RANGE TO THE BUILT-IN MICROWAVE OVENS IS REQUIRED. NOTE: LARGER UNITS REQUIRE GREATER CLEARANCES, REFER TO MANUFACTURER REQUIREMENTS.

ELECTRICAL NOTES:

- ARC FAULT CIRCUIT INTERRUPTER (AFCI) REQUIRED FOR ALL NEW 120-VOLT, SINGLE-PHASE, 15 AND 20 AMPERE BRANCH CIRCUITS SUPPLYING OUTLETS INSTALLED IN KITCHENS, BATHROOMS, FAMILY ROOMS, DINING ROOMS, LIVING ROOMS, PARLORS, LIBRARIES, DENS, BEDROOMS, SUNROOMS, RECREATION ROOMS, CLOSETS, LAUNDRY ROOMS, GARAGE, HALLWAYS, OR SIMILAR ROOMS OR AREAS.
- PER CEC 406.12, PROVIDE TAMPER-RESISTANT RECEPTACLES IN AREAS SPECIFIED IN CEC 210.52, SPECIFICALLY ALL 125-VOLT, 15- AND 20- AMPERE RECEPTACLES IN AREAS SUCH AS KITCHENS, BATHROOMS, FAMILY ROOMS, DINING ROOMS, LIVING ROOMS, PARLORS, LIBRARIES, DENS, SUNROOMS, BEDROOMS, RECREATION ROOMS, LAUNDRY ROOMS, GARAGE, OR SIMILAR ROOMS OR AREAS OF A DWELLING UNIT.
- RECEPTACLES SHALL BE INSTALLED SUCH THAT NO POINT MEASURED HORIZONTALLY ALONG THE FLOOR LINE OF ANY WALL SPACE IS MORE THAN 6 FEET FROM A RECEPTACLE OUTLET. THIS ALLOWS FOR A MAXIMUM OF 12 FEET BETWEEN RECEPTACLES ON THE SAME WALL.
- SMOKE ALARM. WHEN A PERMIT IS REQUIRED FOR ALTERATIONS, REPAIRS OR ADDITIONS EXCEEDING \$1,000, EXISTING DWELLINGS THAT HAVE ATTACHED GARAGES OR FUEL BURNING APPLIANCES, SMOKE DETECTORS SHALL BE INSTALLED: (A) IN EACH SLEEPING ROOM, (B) OUTSIDE EACH SEPARATE SLEEPING AREA IN THE IMMEDIATE VICINITY OF THE BEDROOMS, (C) ON EACH STORY OF THE DWELLING, INCLUDING BASEMENTS AND HABITABLE ATTICS BUT NOT INCLUDING CRAWL SPACES AND UNINHABITABLE ATTICS. NEW SMOKE ALARMS TO BE INTERCONNECTED. SMOKE ALARMS SHALL RECEIVE THEIR PRIMARY POWER FROM THE BUILDING WIRING PROVIDED THAT SUCH WIRING IS SERVED FROM A COMMERCIAL SOURCE AND SHALL BE EQUIPPED WITH A BATTERY BACKUP. SMOKE ALARMS WITH INTEGRAL STROBES THAT ARE NOT EQUIPPED WITH BATTERY BACKUP SHALL BE CONNECTED TO AN EMERGENCY ELECTRICAL SYSTEM. SMOKE ALARMS SHALL EMIT A SIGNAL WHEN THE BATTERIES ARE LOW. WIRING SHALL BE PERMANENT AND WITHOUT A DISCONNECTING SWITCH OTHER THAN AS REQUIRED FOR OVERCURRENT PROTECTION.
- CARBON MONOXIDE ALARM. WHEN A PERMIT IS REQUIRED FOR ALTERATIONS, REPAIRS OR ADDITIONS EXCEEDING \$1,000, EXISTING DWELLINGS THAT HAVE ATTACHED GARAGES OR FUEL BURNING APPLIANCES SHALL BE PROVIDED WITH A CARBON MONOXIDE ALARM IN THE FOLLOWING LOCATIONS: (A) OUTSIDE OF THE DWELLING UNIT SLEEPING AREA IN THE IMMEDIATE VICINITY OF THE BEDROOM(S); (B) ON EVERY LEVEL OF A DWELLING UNIT INCLUDING BASEMENTS. CARBON MONOXIDE ALARMS SHALL RECEIVE THEIR PRIMARY POWER FROM THE BUILDING WIRING WHERE SUCH WIRING IS SERVED FROM A COMMERCIAL SOURCE AND, WHERE PRIMARY POWER IS INTERRUPTED, SHALL RECEIVE POWER FROM A BATTERY. WIRING SHALL BE PERMANENT AND WITHOUT A DISCONNECTING SWITCH OTHER THAN THOSE REQUIRED FOR OVERCURRENT PROTECTION. COMBINATION CARBON MONOXIDE AND SMOKE ALARMS SHALL BE PERMITTED TO BE USED IN LIEU OF CARBON MONOXIDE ALARMS.
- ANY SMOKE ALARM WITHIN 20 FEET OF A PERMANENTLY INSTALLED COOKING APPLIANCE SHALL BE THE IONIZATION OR PHOTOELECTRIC ALARM TYPE AND HAVE A MINIMUM SPACING OF 10 FEET AWAY.
- UNDER CABINET LUMINAIRES SHALL BE SEPERATELY SWITCHED
- A MINIMUM OF (2) 20 AMP GFCI PROTECTED CIRCUITS SHALL SUPPLY ALL KITCHEN COUNTER TOP RECEPTACLES, CEC 210.11 (C)(2), & (C) (3).
- PROVIDE 20 AMP DEDICATED CIRCUITS FOR THE DISHWASHER, GARBAGE DISPOSAL, REFRIGERATOR, MICROWAVE AND RANGE
- RECEPTACLE OUTLETS SHALL BE LOCATED NO MORE THAN 20" ABOVE COUNTER TOP AND NO MORE THAN 12" BELOW IF COUNTER DOES NOT EXTEND MORE THAN 6" FROM BASE. PENINSULA COUNTERTOP SPACES 24" LONG OR GREATER AND SHORT DIMENSION 12" OR GREATER SHALL HAVE AT LEAST ONE RECEPTACLE.
- ALL KITCHEN RECEPTACLES SHALL BE GFCI PROTECTED. CEC 210(A) 5 & 6.
- THE KITCHEN COUNTERTOP WALLS SHALL BE NO MORE THAN 24" FROM A GFCI OUTLET. THIS DOES NOT APPLY TO ANY COUNTERTOP WALLS BEHIND SINKS, RANGES OR MOUNTED COOKTOPS.
- THE UNDERCOUNTER ELECTRICAL OUTLET SERVING THE DISHWASHER SHALL BE GFCI PROTECTED. MULTI-WIRE DUPLEX RECEPTACLES FOR GARBAGE DISPOSALS & DISHWASHERS REQUIRE A COMMON TRIP BREAKER IN THE SERVICE PANELS.
- THE MAXIMUM LENGTH FOR A GARBAGE DISPOSAL CORD IS 36" AND A DISHWASHER IS 48". ATTACHMENT PLUG AND RECEPTACLE SHALL BE ACCESSIBLE AND LABELED.
- ISLANDS OR PENINSULAS REQUIRE AT LEAST 1 RECEPTACLE. RECEPTACLES MAY NOT BE MORE THAN 12" BELOW THE COUNTER SURFACE OR BE BELOW A COUNTER THAT EXTENDS MORE THAN 6" BEYOND A CABINETS END.
- A MINIMUM OF 3'-0" CLEARANCE IS REQUIRED BETWEEN THE COUNTER FRONTS AND APPLIANCES, OR COUNTER FRONTS AND WALLS.

Revision History

	AS-BUILT
	PRELIMINARY DESIGN
	DESIGN
	PERMIT SET
1	PLAN REVIEW COMMENTS
2	PLAN REVIEW COMMENTS

REMODEL & ADDITION

OWNER:

Drawing By:

Chris Klimen

klimen@att.net

PH: 510.928.1359

Peter Christopher Klimen

DIGITALLY SIGNED BY PETER CHRISTOPHER KLIMEN
EMAIL: KLIMEN@ATT.NET DATE: 00/00/00

CODE & CONSTRUCTION NOTES

A0.2



2016 CALIFORNIA GREEN BUILDING STANDARDS CODE

RESIDENTIAL MANDATORY MEASURES, SHEET 1 (INCLUDING JULY 1, 2018, INTERVENING SUPPLEMENT)

CHAPTER 3 GREEN BUILDING SECTION 301 GENERAL

301.1 SCOPE. Buildings shall be designed to include the green building measures specified as mandatory in the application checklists contained in this code. Voluntary green building measures are also included in the application checklists and may be included in the design and construction of structures covered by this code, but are not required unless adopted by a city, county, or city and county as specified in Section 101.7.

301.1.1 Additions and alterations. [HCD] The mandatory provisions of Chapter 4 shall be applied to additions or alterations of existing residential buildings where the addition or alteration increases the building's conditioned area, volume, or size. The requirements shall apply only to and/or within the specific area of the addition or alteration.

Note: On and after January 1, 2014, residential buildings undergoing permitted alterations, additions, or improvements shall replace noncompliant plumbing fixtures with water-conserving plumbing fixtures. Plumbing fixture replacement is required prior to issuance of a certificate of final completion, certificate of occupancy or final permit approval by the local building department. See Civil Code Section 1101.1, et seq., for the definition of a noncompliant plumbing fixture, types of residential buildings affected and other important enactment dates.

301.2 LOW-RISE AND HIGH-RISE RESIDENTIAL BUILDINGS. [HCD] The provisions of individual sections of CALGreen may apply to either low-rise residential buildings high-rise residential buildings, or both. Individual sections will be designated by banners to indicate where the section applies specifically to low-rise only (LR) or high-rise only (HR). When the section applies to both low-rise and high-rise buildings, no banner will be used.

SECTION 302 MIXED OCCUPANCY BUILDINGS

302.1 MIXED OCCUPANCY BUILDINGS. In mixed occupancy buildings, each portion of a building shall comply with the specific green building measures applicable to each specific occupancy.

ABBREVIATION DEFINITIONS:

HCD	Department of Housing and Community Development
BSC	California Building Standards Commission
DSA-SS	Division of the State Architect, Structural Safety
OSHPD	Office of Statewide Health Planning and Development
LR	Low Rise
HR	High Rise
AA	Additions and Alterations
N	New

CHAPTER 4 RESIDENTIAL MANDATORY MEASURES

DIVISION 4.1 PLANNING AND DESIGN

SECTION 4.102 DEFINITIONS

4.102.1 DEFINITIONS
The following terms are defined in Chapter 2 (and are included here for reference)

FRENCH DRAIN. A trench, hole or other depressed area loosely filled with rock, gravel, fragments of brick or similar porous material used to collect or channel drainage or runoff water.

WATTLES. Wattles are used to reduce sediment in runoff. Wattles are often constructed of natural plant materials such as hay, straw or similar material shaped in the form of tubes and placed on a downhill slope. Wattles are also used for perimeter and inlet controls.

4.106 SITE DEVELOPMENT

4.106.1 GENERAL. Preservation and use of available natural resources shall be accomplished through evaluation and careful planning to minimize negative effects on the site and adjacent areas. Preservation of slopes, management of storm water drainage and erosion controls shall comply with this section.

4.106.2 STORM WATER DRAINAGE AND RETENTION DURING CONSTRUCTION. Projects which disturb less than one acre of soil and are not part of a larger common plan of development which in total disturbs one acre or more, shall manage storm water drainage during construction. In order to manage storm water drainage during construction, one or more of the following measures shall be implemented to prevent flooding of adjacent property, prevent erosion and retain soil runoff on the site.

- Retention basins of sufficient size shall be utilized to retain storm water on the site.
- Where storm water is conveyed to a public drainage system, collection point, gutter or similar disposal method, water shall be filtered by use of a barrier system, wattle or other method approved by the enforcing agency.
- Compliance with a lawfully enacted storm water management ordinance.

4.106.3 GRADING AND PAVING. Construction plans shall indicate how the site grading or drainage system will manage all surface water flows to keep water from entering buildings. Examples of methods to manage surface water include, but are not limited to, the following:

- Swales
- Water collection and disposal systems
- French drains
- Water retention gardens
- Other water measures which keep surface water away from buildings and aid in groundwater recharge.

Exception: Additions and alterations not altering the drainage path.

4.106.4 Electric vehicle (EV) charging for new construction. New construction shall comply with Sections 4.106.4.1, 4.106.4.2, or 4.106.4.3 to facilitate future installation and use of EV chargers. Electric vehicle supply equipment (EVSE) shall be installed in accordance with the California Electrical Code, Article 625.

Exceptions: On a case-by-case basis, where the local enforcing agency has determined EV charging and infrastructure are not feasible based upon one or more of the following conditions:

- Where there is no commercial power supply.
- Where there is evidence substantiating that meeting the requirements will alter the local utility infrastructure design requirements on the utility side of the meter so as to increase the utility side cost to the homeowner or developer by more than \$400.00 per unit.

4.106.4.1 New one- and two-family dwellings and townhouses with attached private garages. For each dwelling unit, install a listed raceway to accommodate a dedicated 208/240-volt branch circuit. The raceway shall not be less than trade size 1 (nominal 1-inch inside diameter). The raceway shall originate at the main service or subpanel and shall terminate into a listed cabinet, box or other enclosure in close proximity to the proposed location of an EV charger. Raceways are required to be continuous at enclosed, inaccessible or concealed areas and spaces. The service panel and/or subpanel shall provide capacity to install a 40-ampere minimum dedicated branch circuit and space(s) reserved to permit installation of a branch circuit overcurrent protective device.

4.106.4.1.1 Identification. The service panel or subpanel circuit directory shall identify the overcurrent protective device space(s) reserved for future EV charging as "EV CAPABLE". The raceway termination location shall be permanently and visibly marked as "EV CAPABLE".

4.106.4.2 New multifamily dwellings. Where 17 or more multifamily dwelling units are constructed on a building site, 3 percent of the total number of parking spaces provided for all types of parking facilities, but in no case less than one, shall be electric vehicle charging stations (EV spaces) capable of supporting future EVSE. Calculations for the number of EV spaces shall be rounded up to the nearest whole number.

Note: Construction documents are intended to demonstrate the project's capability and capacity for facilitating future EV charging. There is no requirement for EV spaces to be constructed or available until EV chargers are installed for use.

4.106.4.2.1 Electric vehicle charging space (EV space) locations. Construction documents shall indicate the location of proposed EV spaces. At least one EV space shall be located in common use areas and available for use by all residents.

When EV chargers are installed, EV spaces required by Section 4.106.2.2, Item 3, shall comply with at least one of the following options:

- The EV space shall be located adjacent to an accessible parking space meeting the requirements of the California Building Code, Chapter 11A, to allow use of the EV charger from the accessible parking space.
- The EV space shall be located on an accessible route, as defined in the California Building Code, Chapter 2, to the building.

4.106.4.2.2 Electric vehicle charging space (EV space) dimensions. The EV space shall be designed to comply with the following:

- The minimum length of each EV space shall be 18 feet (5486 mm).
- The minimum width of each EV space shall be 9 feet (2743 mm).
- One in every 25 EV spaces, but not less than one EV space, shall have an 8-foot (2438 mm) wide minimum aisle. A 5-foot (1524 mm) wide minimum aisle shall be permitted provided the minimum width of the EV space is 12 feet (3658 mm).
 - Surface slope for this EV space and the aisle shall not exceed 1 unit vertical in 48 units horizontal (2.083 percent slope) in any direction.

4.106.4.2.3 Single EV space required. Install a listed raceway capable of accommodating a 208/240-volt dedicated branch circuit. The raceway shall not be less than trade size 1 (nominal 1-inch inside diameter). The raceway shall originate at the main service or subpanel and shall terminate into a listed cabinet, box or enclosure in close proximity to the proposed location of the EV space. Construction documents shall identify the raceway termination point. The service panel and/or subpanel shall provide capacity to install a 40-ampere minimum dedicated branch circuit and space(s) reserved to permit installation of a branch circuit overcurrent protective device.

4.106.4.2.4 Multiple EV spaces required. Construction documents shall indicate the raceway termination point and proposed location of future EV spaces and EV chargers. Construction documents shall also provide information on amperage of future EVSE, raceway method(s), wiring schematics and electrical load calculations to verify that the electrical panel service capacity and electrical system, including any on-site distribution transformer(s), have sufficient capacity to simultaneously charge all EVs at all required EV spaces at the full rated amperage of the EVSE. Plan design shall be based upon a 40-ampere minimum branch circuit. Required raceways and related components that are planned to be installed underground, enclosed, inaccessible or in concealed areas and spaces shall be installed at the original construction.

4.106.4.2.5 Identification. The service panel or subpanel circuit directory shall identify the overcurrent protective device space(s) reserved for future EV charging purposes as "EV CAPABLE" in accordance with the California Electrical Code.

Notes:

- The California Department of Transportation adopts and publishes the "California Manual on Uniform Traffic Control Devices (California MUTCD)" to provide uniform standards and specifications for all official traffic control devices in California. Zero Emission Vehicle Signs and Pavement Markings can be found in the New Policies & Directives Number 13-01. Website: <http://www.dot.ca.gov/trafficops/policy/13-01.pdf>
- See Vehicle Code Section 22511 for EV charging space signage in off-street parking facilities and for use of EV charging spaces.
- The Governor's Office of Planning and Research (OPR) published a "Zero-Emission Vehicle Community Readiness Guidebook" which provides helpful information for local governments, residents and businesses. Website: http://opr.ca.gov/docs/ZEV_Guidebook.pdf.

4.106.4.3 New hotels and motels. All newly constructed hotels and motels shall provide EV spaces capable of supporting future installation of EVSE. The construction documents shall identify the location of the EV spaces.

Notes:

- Construction documents are intended to demonstrate the project's capability and capacity or facilitating future EV charging.
- There is no requirement for EV spaces to be constructed or available until EV chargers are installed for use.

4.106.4.3.1 Number of required EV spaces. The number of required EV spaces shall be based on the total number of parking spaces provided for all types of parking facilities in accordance with Table 4.106.4.3.1.

Calculations for the required number of EV spaces shall be rounded up to the nearest whole number.

TOTAL NUMBER OF PARKING SPACES	NUMBER OF REQUIRED EV SPACES
0-9	0
10-25	1
26-50	2
51-75	4
76-100	5
101-150	7
151-200	10
201 and over	6 percent of total

4.106.4.3.2 Electric vehicle charging space (EV space) dimensions. The EV spaces shall be designed to comply with the following:

- The minimum length of each EV space shall be 18 feet (5486mm).
- The minimum width of each EV space shall be 9 feet (2743mm)

4.106.4.3.3 Single EV space required. When a single EV space is required, the EV space shall be designed in accordance with Section 4.106.4.2.3.

4.106.4.3.4 Multiple EV spaces required. When multiple EV spaces are required, the EV spaces shall be designed in accordance with Section 4.106.4.2.4.

4.106.4.3.5 Identification. The service panels or sub-panels shall be identified in accordance with Section 4.106.4.2.5.

4.106.4.3.6 Accessible EV spaces. In addition to the requirements in Section 4.106.4.3, EV spaces for hotels/motels and all EVSE, when installed, shall comply with the accessibility provisions for the EV charging stations in the California Building Code, Chapter 11B.

Notes:

- The California Department of Transportation adopts and publishes the "California Manual on Uniform Traffic Control Devices (California MUTCD)" to provide uniform standards and specifications for all official traffic control devices in California. Zero Emission Vehicle Signs and Pavement Markings can be found in the New Policies & Directives Number 13.01. Website: <http://www.dot.ca.gov/trafficops/policy/html>
- See vehicle Code Section 22511 for EV charging space signage in off-street parking facilities and for use of EV charging spaces.
- The Governor's Office of Planning and Research (OPR) published a "Zero-Emission Vehicle Community Readiness Guidebook" which provides helpful information for local governments, residents and businesses. Website: https://opr.ca.gov/docs/ZEV_Guidebook.pdf.
- The Governor's Interagency Working Group on Zero-Emission Vehicles, 2016, "2016 ZEV Action Plan, An Updated Roadmap toward 1.5 Million Zero-Emission Vehicles on California Roadways by 2025." https://www.gov.ca.gov/docs/2016_ZEV_Action_Plan.pdf.

DIVISION 4.3 WATER EFFICIENCY AND CONSERVATION

4.303 INDOOR WATER USE

4.303.1 WATER CONSERVING PLUMBING FIXTURES AND FITTINGS. Plumbing fixtures (water closets and urinals) and fittings (faucets and showerheads) shall comply with the following:

4.303.1.1 Water Closets. The effective flush volume of all water closets shall not exceed 1.28 gallons per flush. Tank-type water closets shall be certified to the performance criteria of the U.S. EPA WaterSense Specification for Tank-type Toilets.

Note: The effective flush volume of dual flush toilets is defined as the composite, average flush volume of two reduced flushes and one full flush.

4.303.1.2 Urinals. The effective flush volume of wall mounted urinals shall not exceed 0.125 gallons per flush. The effective flush volume of all other urinals shall not exceed 0.5 gallons per flush.

4.303.1.3 Showerheads.

4.303.1.3.1 Single Showerhead. Showerheads shall have a maximum flow rate of not more than 1.8 gallons per minute at 80 psi. Showerheads shall be certified to the performance criteria of the U.S. EPA WaterSense Specification for Showerheads.

4.303.1.3.2 Multiple Showerheads serving one shower. When a shower is served by more than one showerhead, the combined flow rate of all the showerheads and/or other shower outlets controlled by a single valve shall not exceed 1.8 gallons per minute at 80 psi, or the shower shall be designed to only allow one shower outlet to be in operation at a time.

Note: A hand-held shower shall be considered a showerhead.

4.303.1.4 Faucets.

4.303.1.4.1 Residential Lavatory Faucets. The maximum flow rate of residential lavatory faucets shall not exceed 1.2 gallons per minute at 60 psi. The minimum flow rate of residential lavatory faucets shall not be less than 0.8 gallons per minute at 20 psi.

4.303.1.4.2 Lavatory Faucets in Common and Public Use Areas. The maximum flow rate of lavatory faucets installed in common and public use areas (outside of dwellings or sleeping units) in residential buildings shall not exceed 0.5 gallons per minute at 60 psi.

4.303.1.4.3 Metering Faucets. Metering faucets when installed in residential buildings shall not deliver more than 0.25 gallons per cycle.

4.303.1.4.4 Kitchen Faucets. The maximum flow rate of kitchen faucets shall not exceed 1.8 gallons per minute at 60 psi. Kitchen faucets may temporarily increase the flow above the maximum rate, but not to exceed 2.2 gallons per minute at 60 psi, and must default to a maximum flow rate of 1.8 gallons per minute at 60 psi.

Note: Where complying faucets are unavailable, aerators or other means may be used to achieve reduction.

4.303.2 STANDARDS FOR PLUMBING FIXTURES AND FITTINGS. Plumbing fixtures and fittings shall be installed in accordance with the California Plumbing Code, and shall meet the applicable standards referenced in Table 1701.1 of the California Plumbing Code.

NOTE: THIS TABLE COMPILES THE DATA IN SECTION 4.303.1, AND IS INCLUDED AS A CONVENIENCE FOR THE USER.

TABLE - MAXIMUM FIXTURE WATER USE	
FIXTURE TYPE	FLOW RATE
SHOWER HEADS (RESIDENTIAL)	1.8 GPM @ 80 PSI
LAVATORY FAUCETS (RESIDENTIAL)	MAX. 1.2 GPM @ 60 PSI MIN. 0.8 GPM @ 20 PSI
LAVATORY FAUCETS IN COMMON & PUBLIC USE AREAS	0.5 GPM @ 60 PSI
KITCHEN FAUCETS	1.8 GPM @ 60 PSI
METERING FAUCETS	0.25 GAL/CYCLE
WATER CLOSET	1.28 GAL/FLUSH
URINALS	0.125 GAL/FLUSH

4.304 OUTDOOR WATER USE

4.304.1 OUTDOOR POTABLE WATER USE IN LANDSCAPE AREAS. After December 1, 2015, new residential developments with an aggregate landscape area equal to or greater than 500 square feet shall comply with one of the following options:

- A local water efficient landscape ordinance or the current California Department of Water Resources' Model Water Efficient Landscape Ordinance (MWELO), whichever is more stringent; or
- Projects with aggregate landscape areas less than 2,500 square feet may comply with the MWELO's Appendix D Prescriptive Compliance Option.

NOTES:

- The Model Water Efficient Landscape Ordinance (MWELO) and supporting documents are available at: <http://www.water.ca.gov/wateruseefficiency/landscapeordnace/>
- A water budget calculator is available at: <http://www.water.ca.gov/wateruseefficiency/landscapeordnace/>

DIVISION 4.4 MATERIAL CONSERVATION AND RESOURCE EFFICIENCY

4.406 ENHANCED DURABILITY AND REDUCED MAINTENANCE

4.406.1 RODENT PROOFING. Annular spaces around pipes, electric cables, conduits or other openings in sole/bottom plates at exterior walls shall be protected against the passage of rodents by closing such openings with cement mortar, concrete masonry or a similar method acceptable to the enforcing agency.

4.408 CONSTRUCTION WASTE REDUCTION, DISPOSAL AND RECYCLING

4.408.1 CONSTRUCTION WASTE MANAGEMENT. Recycle and/or salvage for reuse a minimum of 65 percent of the non-hazardous construction and demolition waste in accordance with either Section 4.408.2, 4.408.3 or 4.408.4, or meet a more stringent local construction and demolition waste management ordinance.

Exceptions:

- Excavated soil and land-clearing debris.
- Alternate waste reduction methods developed by working with local agencies if diversion or recycle facilities capable of compliance with this item do not exist or are not located reasonably close to the jobsite.
- The enforcing agency may make exceptions to the requirements of this section when isolated jobsite are located in areas beyond the haul boundaries of the diversion facility.

4.408.2 CONSTRUCTION WASTE MANAGEMENT PLAN. Submit a construction waste management plan in conformance with Items 1 through 5. The construction waste management plan shall be updated as necessary and shall be available during construction for examination by the enforcing agency.

- Identify the construction and demolition waste materials to be diverted from disposal by recycling, reuse on the project or salvage for future use or sale.
- Specify if construction and demolition waste materials will be sorted on-site (source separated) or bulk mixed (single stream).
- Identify diversion facilities where the construction and demolition waste material collected will be taken.
- Identify construction methods employed to reduce the amount of construction and demolition waste generated.
- Specify that the amount of construction and demolition waste materials diverted shall be calculated by weight or volume, but not by both.

4.408.3 WASTE MANAGEMENT COMPANY. Utilize a waste management company, approved by the enforcing agency, which can provide verifiable documentation that the percentage of construction and demolition waste material diverted from the landfill complies with Section 4.408.1.

Note: The owner or contractor may make the determination if the construction and demolition waste materials will be diverted by a waste management company.

4.408.4 WASTE STREAM REDUCTION ALTERNATIVE (LR). Projects that generate a total combined weight of construction and demolition waste disposed of in landfills, which do not exceed 3.4 lbs./sq.ft. of the building area shall meet the minimum 65% construction waste reduction requirement in Section 4.408.1

4.408.4.1 WASTE STREAM REDUCTION ALTERNATIVE. Projects that generate a total combined weight of construction and demolition waste disposed of in landfills, which do not exceed 2 pounds per square foot of the building area, shall meet the minimum 65% construction waste reduction requirement in Section 4.408.1

4.408.5 DOCUMENTATION. Documentation shall be provided to the enforcing agency which demonstrates compliance with Section 4.408.2, Items 1 through 5, Section 4.408.3 or Section 4.408.4.

Notes:

- Sample forms found in "A Guide to the California Green Building Standards Code (Residential)" located at www.hcd.ca.gov/CALGreen.html may be used to assist in documenting compliance with this section.
- Mixed construction and demolition debris (C & D) processors can be located at the California Department of Resources Recycling and Recovery (CalRecycle).

4.410 BUILDING MAINTENANCE AND OPERATION

4.410.1 OPERATION AND MAINTENANCE MANUAL. At the time of final inspection, a manual, compact disc, web-based reference or other media acceptable to the enforcing agency which includes all of the following shall be placed in the building:

- Directions to the owner or occupant that the manual shall remain with the building throughout the life cycle of the structure.
- Operation and maintenance instructions for the following:
 - Equipment and appliances, including water-saving devices and systems, HVAC systems, photovoltaic systems, electric vehicle chargers, water-heating systems and other major appliances and equipment.
 - Roof and yard drainage, including gutters and downspouts.
 - Space conditioning systems, including condensers and air filters.
 - Landscape irrigation systems.
 - Water reuse systems.
- Information from local utility, water and waste recovery providers on methods to further reduce resource consumption, including recycle programs and locations.
- Public transportation and/or carpool options available in the area.
- Educational material on the positive impacts of an interior relative humidity between 30-60 percent and what methods an occupant may use to maintain the relative humidity level in that range.
- Information about water-conserving landscape and irrigation design and controllers which conserve water.
- Instructions for maintaining gutters and downspouts and the importance of diverting water at least 5 feet away from the foundation.
- Information on required routine maintenance measures, including, but not limited to, caulking, painting, grading around the building, etc.
- Information about state solar energy and incentive programs available.
- A copy of all special inspections verifications required by the enforcing agency or this [California Green Building Standards Code].

4.410.2 RECYCLING BY OCCUPANTS. Where 5 or more multifamily dwelling units are constructed on a building site, provide readily accessible area(s) that serves all buildings on the site and is identified for the depositing, storage and collection of non-hazardous materials for recycling, including (at a minimum) paper, corrugated cardboard, glass, plastics, organic waste, and metals, or meet a lawfully enacted local recycling ordinance, if more restrictive.

Exception: Rural jurisdictions that meet and apply for the exemption in Public Resources Code Section 42649.82 (a)(2)(A) et seq. are not required to comply with the organic waste portion of this section.

DIVISION 4.5 ENVIRONMENTAL QUALITY

SECTION 4.501 GENERAL

4.501.1 Scope. The provisions of this chapter shall outline means of reducing the quality of air contaminants that are odorous, irritating and/or harmful to the comfort and well being of a building's installers, occupants and neighbors.

SECTION 4.502 DEFINITIONS

5.102.1 DEFINITIONS
The following terms are defined in Chapter 2 (and are included here for reference)

AGRIFIBER PRODUCTS. Agrifiber products include wheatboard, strawboard, panel substrates and door cores, not including furniture, fixtures and equipment (FF&E) not considered base building elements.

COMPOSITE WOOD PRODUCTS. Composite wood products include hardwood plywood, particleboard and medium density fiberboard. "Composite wood products" does not include hardwood, structural plywood, structural panels, structural composite lumber, oriented strand board, glued laminated timber, prefabricated wood I-joists or finger-jointed lumber, all as specified in California Code of regulations (CCR), title 17, Section 93120.1.

DIRECT-VENT APPLIANCE. A fuel-burning appliance with a sealed combustion system that draws all air for combustion from the outside atmosphere and discharges all flue gases to the outside atmosphere.

Revision History	
	AS-BUILT
	PRELIMINARY DESIGN
	DESIGN
	PERMIT SET
1	PLAN REVIEW COMMENTS
2	PLAN REVIEW COMMENTS

REMODEL & ADDITION
OWNER:

Drawing By:
Chris Klimen
klimen@att.net
PH: 510.928.1359
Peter Christopher Klimen
DIGITALLY SIGNED BY PETER CHRISTOPHER KLIMEN
EMAIL:KLIMEN@ATT.NET DATE: 000000

REQUIREMENTS
PAGE 1

CAL GREEN REQUIREMENTS
PAGE 1

G1.0



2016 CALIFORNIA GREEN BUILDING STANDARDS CODE RESIDENTIAL MANDATORY MEASURES, SHEET 2 (INCLUDING JULY 1, 2018, INTERVENING SUPPLEMENT)

Y NA RESPON PARTY
NA RESPON PARTY
YES APPLICABLE RESPONSIBLE PARTY (i.e. ARCHITECT, ENGINEER, OWNER, CONTRACTOR, INSPECTOR ETC.)

MAXIMUM INCREMENTAL REACTIVITY (MIR). The maximum change in weight of ozone formed by adding a compound to the "Base Reactive Organic Gas (ROG) Mixture" per weight of compound added, expressed to hundredths of a gram (g O₃/g ROG).
Note: MIR values for individual compounds and hydrocarbon solvents are specified in CCR, Title 17, Sections 94700 and 94701.

MOISTURE CONTENT. The weight of the water in wood expressed in percentage of the weight of the oven-dry wood.

PRODUCT-WEIGHTED MIR (PWMIR). The sum of all weighted-MIR for all ingredients in a product subject to this article. The PWMIR is the total product reactivity expressed to hundredths of a gram of ozone formed per gram of product (excluding container and packaging).
Note: PWMIR is calculated according to equations found in CCR, Title 17, Section 94521 (a).

REACTIVE ORGANIC COMPOUND (ROC). Any compound that has the potential, once emitted, to contribute to ozone formation in the troposphere.

VOC. A volatile organic compound (VOC) broadly defined as a chemical compound based on carbon chains or rings with vapor pressures greater than 0.1 millimeters of mercury at room temperature. These compounds typically contain hydrogen and may contain oxygen, nitrogen and other elements. See CCR Title 17, Section 94508(a).

4.503 FIREPLACES
4.503.1 GENERAL. Any installed gas fireplace shall be a direct-vent sealed-combustion type. Any installed woodstove or pellet stove shall comply with U.S. EPA New Source Performance Standards (NSPS) emission limits as applicable, and shall have a permanent label indicating they are certified to meet the emission limits. Woodstoves, pellet stoves and fireplaces shall also comply with applicable local ordinances.

4.504 POLLUTANT CONTROL
4.504.1 COVERING OF DUCT OPENINGS & PROTECTION OF MECHANICAL EQUIPMENT DURING CONSTRUCTION. At the time of rough installation, during storage on the construction site and until final startup of the heating, cooling and ventilating equipment, all duct and other related air distribution component openings shall be covered with tape, plastic, sheet metal or other methods acceptable to the enforcing agency to reduce the amount of water, dust or debris which may enter the system.

4.504.2 FINISH MATERIAL POLLUTANT CONTROL. Finish materials shall comply with this section.

4.504.2.1 Adhesives, Sealants and Caulks. Adhesives, sealant and caulks used on the project shall meet the requirements of the following standards unless more stringent local or regional air pollution or air quality management district rules apply:

- Adhesives, adhesive bonding primers, adhesive primers, sealants, sealant primers and caulks shall comply with local or regional air pollution control or air quality management district rules where applicable or SCAQMD Rule 1168 VOC limits, as shown in Table 4.504.1 or 4.504.2, as applicable. Such products also shall comply with the Rule 1168 prohibition on the use of certain toxic compounds (chloroform, ethylene dichloride, methylene chloride, perchloroethylene and trichloroethylene), except for aerosol products, as specified in Subsection 2 below.
- Aerosol adhesives, and smaller unit sizes of adhesives, and sealant or caulking compounds (in units of product, less packaging, which do not weigh more than 1 pound and do not consist of more than 16 fluid ounces) shall comply with statewide VOC standards and other requirements, including prohibitions on use of certain toxic compounds, of California Code of Regulations, Title 17, commencing with Section 94507.

4.504.2.2 Paints and Coatings. Architectural paints and coatings shall comply with VOC limits in Table 1 of the ARB Architectural Suggested Control Measure, as shown in Table 4.504.3, unless more stringent local rules apply. The VOC content limit for coatings that do not meet the definitions for the specialty coatings categories listed in Table 4.504.3 shall be determined by classifying the coating as a Flat, Nonflat or Nonflat-High Gloss coating, based on its gloss, as defined in subsections 4.21, 4.36, and 4.37 of the 2007 California Air Resources Board, Suggested Control Measure, and the corresponding Flat, Nonflat or Nonflat-High Gloss VOC limit in Table 4.504.3 shall apply.

4.504.2.3 Aerosol Paints and Coatings. Aerosol paints and coatings shall meet the Product-weighted MIR Limits for ROC in Section 94522(a)(2) and other requirements, including prohibitions on use of certain toxic compounds and ozone depleting substances, in Sections 94522(e)(1) and (f)(1) of California Code of Regulations, Title 17, commencing with Section 94520; and in areas under the jurisdiction of the Bay Area Air Quality Management District additionally comply with the percent VOC by weight of product limits of Regulation 8, Rule 49.

4.504.2.4 Verification. Verification of compliance with this section shall be provided at the request of the enforcing agency. Documentation may include, but is not limited to, the following:

- Manufacturer's product specification.
- Field verification of on-site product containers.

TABLE 4.504.1 - ADHESIVE VOC LIMIT_{1,2}
(Less Water and Less Exempt Compounds in Grams per Liter)

ARCHITECTURAL APPLICATIONS	VOC LIMIT
INDOOR CARPET ADHESIVES	50
CARPET PAD ADHESIVES	50
OUTDOOR CARPET ADHESIVES	150
WOOD FLOORING ADHESIVES	100
RUBBER FLOOR ADHESIVES	60
SUBFLOOR ADHESIVES	50
CERAMIC TILE ADHESIVES	65
VCT & ASPHALT TILE ADHESIVES	50
DRYWALL & PANEL ADHESIVES	50
COVE BASE ADHESIVES	50
MULTIPURPOSE CONSTRUCTION ADHESIVE	70
STRUCTURAL GLAZING ADHESIVES	100
SINGLE-PLY ROOF MEMBRANE ADHESIVES	250
OTHER ADHESIVES NOT LISTED	50
SPECIALTY APPLICATIONS	
PVC WELDING	510
CPVC WELDING	490
ABS WELDING	325
PLASTIC CEMENT WELDING	250
ADHESIVE PRIMER FOR PLASTIC	550
CONTACT ADHESIVE	80
SPECIAL PURPOSE CONTACT ADHESIVE	250
STRUCTURAL WOOD MEMBER ADHESIVE	140
TOP & TRIM ADHESIVE	250
SUBSTRATE SPECIFIC APPLICATIONS	
METAL TO METAL	30
PLASTIC FOAMS	50
POROUS MATERIAL (EXCEPT WOOD)	50
WOOD	30
FIBERGLASS	80

1. IF AN ADHESIVE IS USED TO BOND DISSIMILAR SUBSTRATES TOGETHER, THE ADHESIVE WITH THE HIGHEST VOC CONTENT SHALL BE ALLOWED.
2. FOR ADDITIONAL INFORMATION REGARDING METHODS TO MEASURE THE VOC CONTENT SPECIFIED IN THIS TABLE, SEE SOUTH COAST AIR QUALITY MANAGEMENT DISTRICT RULE 1168.

TABLE 4.504.2 - SEALANT VOC LIMIT
(Less Water and Less Exempt Compounds in Grams per Liter)

SEALANTS	VOC LIMIT
ARCHITECTURAL	250
MARINE DECK	760
NONMEMBRANE ROOF	300
ROADWAY	250
SINGLE-PLY ROOF MEMBRANE	450
OTHER	420
SEALANT PRIMERS	
ARCHITECTURAL	
NON-POROUS	250
POROUS	775
MODIFIED BITUMINOUS	500
MARINE DECK	760
OTHER	750

TABLE 4.504.3 - VOC CONTENT LIMITS FOR ARCHITECTURAL COATINGS_{1,2}
(GRAMS OF VOC PER LITER OF COATING, LESS WATER & LESS EXEMPT COMPOUNDS)

COATING CATEGORY	VOC LIMIT
FLAT COATINGS	50
NON-FLAT COATINGS	100
NONFLAT-HIGH GLOSS COATINGS	150
SPECIALTY COATINGS	
ALUMINUM ROOF COATINGS	400
BASEMENT SPECIALTY COATINGS	400
BITUMINOUS ROOF COATINGS	50
BITUMINOUS ROOF PRIMERS	350
BOND BREAKERS	350
CONCRETE CURING COMPOUNDS	350
CONCRETE/MASONRY SEALERS	100
DRIVEWAY SEALERS	50
DRY FOG COATINGS	150
FAUX FINISHING COATINGS	350
FIRE RESISTIVE COATINGS	350
FLOOR COATINGS	100
FORM-RELEASE COMPOUNDS	250
GRAPHIC ARTS COATINGS (SIGN PAINTS)	500
HIGH TEMPERATURE COATINGS	420
INDUSTRIAL MAINTENANCE COATINGS	250
LOW SOLIDS COATINGS ₁	100
MAGNESITE CEMENT COATINGS	450
MASTIC TEXTURE COATINGS	100
METALLIC PIGMENTED COATINGS	500
MULTICOLOR COATINGS	250
PRETREATMENT WASH PRIMERS	420
PRIMERS, SEALERS, & UNDERCOATERS	100
REACTIVE PENETRATING SEALERS	350
RECYCLED COATINGS	250
ROOF COATINGS	50
RUST PREVENTATIVE COATINGS	250
SHELLACS	
CLEAR	730
OPAQUE	550
SPECIALTY PRIMERS, SEALERS & UNDERCOATERS	100
STAINS	250
STONE CONSOLIDANTS	450
SWIMMING POOL COATINGS	340
TRAFFIC MARKING COATINGS	100
TUB & TILE REFINISH COATINGS	420
WATERPROOFING MEMBRANES	250
WOOD COATINGS	275
WOOD PRESERVATIVES	350
ZINC-RICH PRIMERS	340

1. GRAMS OF VOC PER LITER OF COATING, INCLUDING WATER & EXEMPT COMPOUNDS
2. THE SPECIFIED LIMITS REMAIN IN EFFECT UNLESS REVISED LIMITS ARE LISTED IN SUBSEQUENT COLUMNS IN THE TABLE.
3. VALUES IN THIS TABLE ARE DERIVED FROM THOSE SPECIFIED BY THE CALIFORNIA AIR RESOURCES BOARD, ARCHITECTURAL COATINGS SUGGESTED CONTROL MEASURE, FEB. 1, 2008. MORE INFORMATION IS AVAILABLE FROM THE AIR RESOURCES BOARD.

TABLE 4.504.5 - FORMALDEHYDE LIMITS.
MAXIMUM FORMALDEHYDE EMISSIONS IN PARTS PER MILLION

PRODUCT	CURRENT LIMIT
HARDWOOD PLYWOOD VENEER CORE	0.05
HARDWOOD PLYWOOD COMPOSITE CORE	0.05
PARTICLE BOARD	0.09
MEDIUM DENSITY FIBERBOARD	0.11
THIN MEDIUM DENSITY FIBERBOARD ₁	0.13

1. VALUES IN THIS TABLE ARE DERIVED FROM THOSE SPECIFIED BY THE CALIF. AIR RESOURCES BOARD, AIR TOXICS CONTROL MEASURE FOR COMPOSITE WOOD AS TESTED IN ACCORDANCE WITH ASTM E 1333. FOR ADDITIONAL INFORMATION, SEE CALIF. CODE OF REGULATIONS, TITLE 17, SECTIONS 93120 THROUGH 93120.12.
2. THIN MEDIUM DENSITY FIBERBOARD HAS A MAXIMUM THICKNESS OF 5/16" (8 MM).

DIVISION 4.5 ENVIRONMENTAL QUALITY (continued)
4.504.3 CARPET SYSTEMS. All carpet installed in the building interior shall meet the testing and product requirements of at least one of the following:

- Carpet and Rug Institute's Green Label Plus Program.
- California Department of Public Health, "Standard Method for the Testing and Evaluation of Volatile Organic Chemical Emissions from Indoor Sources Using Environmental Chambers" Version 1.1, February 2010 (also known as Specification 01350), certified as a CHPS Low-Emitting Material in the Collaborative for High Performance Schools (CHPS) High Performance Products Database.
- NSF/ANSI 140 at the carpet level.
- Scientific Certifications Systems Indoor Advantage Gold.

4.504.3.1 Carpet cushion. All carpet cushion installed in the building interior shall meet the requirements of the Carpet and Rug Institute's Green Label program.

4.504.3.2 Carpet adhesive. All carpet adhesive shall meet the requirements of Table 4.504.1.

4.504.4 RESILIENT FLOORING SYSTEMS. Where resilient flooring is installed, at least 80% of floor area receiving resilient flooring shall comply with one or more of the following:

- Products compliant with the California Department of Public Health, "Standard Method for the Testing and Evaluation of Volatile Organic Chemical Emissions from Indoor Sources Using Environmental Chambers," Version 1.1, February 2010 (also known as Specification 01350), certified as a CHPS Low-Emitting Material in the Collaborative for High Performance Schools (CHPS) High Performance Products Database.
- Products certified under UL GREENGUARD Gold (formerly the Greenguard Children & Schools program).
- Verification under the Resilient Floor Covering Institute (RFCI) FloorScore program.
- Meet the California Department of Public Health, "Standard Method for the Testing and Evaluation of Volatile Organic Chemical Emissions from Indoor Sources Using Environmental Chambers," Version 1.1, February 2010 (also known as Specification 01350).

4.504.5 COMPOSITE WOOD PRODUCTS. Hardwood plywood, particleboard and medium density fiberboard composite wood products used on the interior or exterior of the buildings shall meet the requirements for formaldehyde as specified in ANSI's Air Toxics Control Measure for Composite Wood (17 CCR 93120 et seq.), by or before the dates specified in those sections, as shown in Table 4.504.5.

4.504.5.1 Documentation. Verification of compliance with this section shall be provided as requested by the enforcing agency. Documentation shall include at least one of the following:

- Product certifications and specifications.
- Chain of custody certifications.
- Product labeled and invoiced as meeting the Composite Wood Products regulation (see CCR, Title 17, Section 93120, et seq.).
- Exterior grade products marked as meeting the PS-1 or PS-2 standards of the Engineered Wood Association, the Australian AS/NZS 2269, European 636 3S standards, and Canadian CSA 0121, CSA 0151, CSA 0153 and CSA 0325 standards.
- Other methods acceptable to the enforcing agency.

4.505 INTERIOR MOISTURE CONTROL
4.505.1 General. Buildings shall meet or exceed the provisions of the California Building Standards Code.

4.505.2 CONCRETE SLAB FOUNDATIONS. Concrete slab foundations required to have a vapor retarder by California Building Code, Chapter 19, or concrete slab-on-ground floors required to have a vapor retarder by the California Residential Code, Chapter 5, shall also comply with this section.

4.505.2.1 Capillary break. A capillary break shall be installed in compliance with at least one of the following:

- A 4-inch (101.6 mm) thick base of 1/2 inch (12.7mm) or larger clean aggregate shall be provided with a vapor barrier in direct contact with concrete and a concrete mix design, which will address bleeding, shrinkage, and curling, shall be used. For additional information, see American Concrete Institute, ACI 302.2R-06.
- Other equivalent methods approved by the enforcing agency.
- A slab design specified by a licensed design professional.

4.505.3 MOISTURE CONTENT OF BUILDING MATERIALS. Building materials with visible signs of water damage shall not be installed. Wall and floor framing shall not be enclosed when the framing members exceed 19 percent moisture content. Moisture content shall be verified in compliance with the following:

- Moisture content shall be determined with either a probe-type or contact-type moisture meter. Equivalent moisture verification methods may be approved by the enforcing agency and shall satisfy requirements found in Section 101.8 of this code.
- Moisture readings shall be taken at a point 2 feet (610 mm) to 4 feet (1219 mm) from the grade stamped of each piece verified.
- At least three random moisture readings shall be performed on wall and floor framing with documentation acceptable to the enforcing agency provided at the time of approval to enclose the wall and floor framing.

Insulation products which are visibly wet or have a high moisture content shall be replaced or allowed to dry prior to enclosure in wall or floor cavities. Wet-applied insulation products shall follow the manufacturers' drying recommendations prior to enclosure.

4.506 INDOOR AIR QUALITY AND EXHAUST
4.506.1 Bathroom exhaust fans. Each bathroom shall be mechanically ventilated and shall comply with the following:

- Fans shall be ENERGY STAR compliant and be ducted to terminate outside the building.
- Unless functioning as a component of a whole house ventilation system, fans must be controlled by a humidity control.
 - Humidity controls shall be capable of adjustment between a relative humidity range less than or equal to 50% to a maximum of 80%. A humidity control may utilize manual or automatic means of adjustment.
 - A humidity control may be a separate component to the exhaust fan and is not required to be integral (i.e., built-in).

Notes:

- For the purposes of this section, a bathroom is a room which contains a bathtub, shower or tub/shower combination.
- Lighting integral to bathroom exhaust fans shall comply with the California Energy Code.

4.507 ENVIRONMENTAL COMFORT
4.507.2 HEATING AND AIR-CONDITIONING SYSTEM DESIGN. Heating and air conditioning systems shall be sized, designed and have their equipment selected using the following methods:

- The heat loss and heat gain is established according to ANSI/ACCA 2 Manual 3 - 2011 (Residential Load Calculation), ASHRAE handbooks or other equivalent design software or methods.
- Duct systems are sized according to ANSI/ACCA 1 Manual D - 2014 (Residential Duct Systems), ASHRAE handbooks or other equivalent design software or methods.
- Select heating and cooling equipment according to ANSI/ACCA 3 Manual S - 2014 (Residential Equipment Selection), or other equivalent design software or methods.

Exception: Use of alternate design temperatures necessary to ensure the system functions are acceptable.

**CHAPTER 7
INSTALLER & SPECIAL INSPECTOR QUALIFICATIONS**
702 QUALIFICATIONS
702.1 INSTALLER TRAINING. HVAC system installers shall be trained and certified in the proper installation of HVAC systems including ducts and equipment by a nationally or regionally recognized training or certification program. Uncertified persons may perform HVAC installations when under the direct supervision and responsibility of a person trained and certified to install HVAC systems or contractor licensed to install HVAC systems. Examples of acceptable HVAC training and certification programs include but are not limited to the following:

- State certified apprenticeship programs.
- Public utility training programs.
- Training programs sponsored by trade, labor or statewide energy consulting or verification organizations.
- Programs sponsored by manufacturing organizations.
- Other programs acceptable to the enforcing agency.

702.2 SPECIAL INSPECTION [HCD]. When required by the enforcing agency, the owner or the responsible entity acting as the owner's agent shall employ one or more special inspectors to provide inspection or other duties necessary to substantiate compliance with this code. Special inspectors shall demonstrate competence to the satisfaction of the enforcing agency for the particular type of inspection or task to be performed. In addition to other certifications or qualifications acceptable to the enforcing agency, the following certifications or education may be considered by the enforcing agency when evaluating the qualifications of a special inspector:

- Certification by a national or regional green building program or standard publisher.
- Certification by a statewide energy consulting or verification organization, such as HERS raters, building performance contractors, and home energy auditors.
- Successful completion of a third party apprentice training program in the appropriate trade.
- Other programs acceptable to the enforcing agency.

Notes:

- Special inspectors shall be independent entities with no financial interest in the materials or the project they are inspecting for compliance with this code.
- HERS raters are special inspectors certified by the California Energy Commission (CEC) to rate homes in California according to the Home Energy Rating System (HERS).

[BSC] When required by the enforcing agency, the owner or the responsible entity acting as the owner's agent shall employ one or more special inspectors to provide inspection or other duties necessary to substantiate compliance with this code. Special inspectors shall demonstrate competence to the satisfaction of the enforcing agency for the particular type of inspection or task to be performed. In addition to other certifications or qualifications acceptable to the enforcing agency, the following certifications or education may be considered by the enforcing agency when evaluating the qualifications of a special inspector:

Notes: Special inspectors shall be independent entities with no financial interest in the materials or the project they are inspecting for compliance with this code.

703 VERIFICATIONS
703.1 DOCUMENTATION. Documentation used to show compliance with this code shall include but is not limited to, construction documents, plans, specifications, builder or installer certification, inspection reports, or other methods acceptable to the enforcing agency which demonstrate substantial conformance. When specific documentation or special inspection is necessary to verify compliance, that method of compliance will be specified in the appropriate section or identified applicable checklist.

Revision History	
	AS-BUILT
	PRELIMINARY DESIGN
	DESIGN
	PERMIT SET
1	PLAN REVIEW COMMENTS
2	PLAN REVIEW COMMENTS

REMODEL & ADDITION


OWNER:

Drawing By:
Chris Klimen
klimen@att.net
PH: 510.928.1359

Peter Christopher Klimen
DIGITALLY SIGNED BY PETER CHRISTOPHER KLIMEN
EMAIL: KLIMEN@ATT.NET DATE: 00/00/00

CAL GREEN
REQUIREMENTS
PAGE 2

G1.1

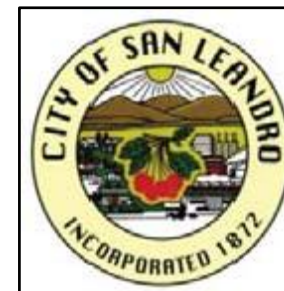

2019 Cal Green Residential Mandatory Measures

New residential buildings shall be designed to include the green building mandatory measures specified in this checklist. This checklist shall also be applied to additions or alterations of existing residential buildings where the addition or alteration increases the buildings conditioned area, volume, or size. The requirements shall apply only to the specific area of the addition or alteration.

BUILDING PERMIT # _____ ADDRESS: 932 BANCROFT AVE

Feature or Measure (for full details of code requirements, see the 2019 Cal Green Code)	Yes/No & Plan Reference
PLANNING AND DESIGN	Plan sheet, Spec or Attach Reference
SITE DEVELOPMENT (CGS 4.106)	
Stormwater pollution control. A plan has been developed and will be implemented to manage storm water drainage during construction per CGC 4.106.2 & 4.106.3.	NA - NO EXTERIOR WORK
Grading and Paving. Construction plans to indicate how site grading and drainage system will manage all water flows to keep water from entering buildings. Examples found at CGC 4.106.3. Alterations and additions are excluded.	NA - NO EXTERIOR WORK
Electric Vehicle Charging for New Construction. For one- and two-family dwellings, install electric vehicle charging wiring and panels per the requirements found in CGC 4.106.4.	NA - NOT NEW CONSTRUCTION
ENERGY EFFICIENCY	
ENERGY CODE	
Energy Efficiency. Building meets or exceed the requirements of the California Building Energy Efficiency Standards.	NEW FIXTURES SHALL BE ENERGY STAR COMPLIANT IF APPLICABLE
WATER EFFICIENCY AND CONSERVATION	
INDOOR WATER USE (CGC 4.303)	
Water conserving plumbing fixtures. Plumbing fixtures (water closets and urinals) shall comply with the following: 1. The effective flush volume of all water closets shall not exceed 1.28 gal/flush (CGC 403.1.1). 2. The effective flush volume of wall-mounted urinals shall not exceed 0.125 gal/flush. The effective flush volume for all other urinals shall not exceed 0.5 gal/flush (CGC 403.1.2).	NEW KITCHEN FIXTURES TO COMPLY WITH SECTION 4.303.2
Water conserving plumbing fittings. Fittings (faucets and showerheads) have all required standards listed on plans and are in accordance to CGC 4.303.1.3 and CGC 403.1.4.	SEE ABOVE
OUTDOOR WATER USE (CGC 4.304)	
Scope. The provisions of Section 4.304 reference the mandatory Model Water Efficiency Landscape Ordinance (MWELo) contained within Chapter 2.7, Division 2, Title 23 per CGC 4.304.1.	NA - NO EXTERIOR WORK
Outdoor water use in landscape areas equal to or greater than 500 square feet. For new residential developments with aggregate landscape area equal to or greater than 500 square feet, shall comply with local water efficient landscape ordinance or the current MWELo per CGC 4.304.1.	NA - NOT NEW CONSTRUCTION
Outdoor water use in landscape areas of 2,500 square feet or less. New residential development with aggregate landscape area of 2,500 square feet or less may conform to the prescriptive compliance measures contained in MWELo's Appendix D.	NA - NOT NEW CONSTRUCTION
MATERIAL CONSERVATION AND RESOURCE EFFICIENCY	
ENHANCED DURABILITY AND REDUCED MAINTENANCE (CGC 4.406)	
Rodent Proofing. Annular spaces around pipes, electric cables, conduits or other openings in sole/bottom plates at exterior walls shall be rodent proofed by closing such openings with cement mortar, concrete masonry, or similar methods acceptable to the enforcing agency per CGC 4.406.1.	NOTED ON SHEET A1.10
CONSTRUCTION WASTE REDUCTION, DISPOSAL AND RECYCLING (CGC 4.408)	
Construction waste management. Recycle and/or salvage for reuse a minimum of 65% of the nonhazardous construction and demolition waste per CGC 4.408.1	NOTED ON COVER, A0.1
BUILDING MAINTENANCE AND OPERATION (CGC 4.410)	
Operation and maintenance manual. An operation and maintenance manual will be provided to the building occupant or owner per CGC 4.410.1.	NOTED ON SHEET A1.10
Recycling by occupants. Where five (5) or more multifamily dwelling units are constructed on a single site, provide readily accessible collection areas that serve all buildings on the site for depositing storage and collection of non-hazardous recyclables (including paper, corrugated cardboard, glass, plastics, organic waste, and metals) per CGC 4.410.2.	NA
ENVIRONMENTAL QUALITY	

Fireplaces. Any gas fireplaces shall be a direct-vent sealed-combustible type.	
Woodstoves. Any wood stove or pellet stove shall comply with US EPA New Source Performance Standards emission limits per CGC 4.503.1.	NA
POLLUTANT CONTROL (CGC 4.504)	
Duct and mechanical systems protection. At the time of rough installation, during storage on the construction site and until final startup of the heating, cooling and ventilating equipment, all duct and other related air distribution components openings shall be covered with tape, plastic, sheet metal, or other methods acceptable to the enforcing agency to reduce the amount of water, dust or debris, which may enter the system per CGC 4.504.1.	NOTED ON SHEET A1.10
Finish material pollutant control. Finish materials shall comply with Sections 4.504.2.1 through 4.504.5.1.	NOTED ON SHEET A1.10
Adhesives, sealants and caulks. Adhesives, sealants and caulks used on the project shall meet the requirements of the standards listed in CGC 4.504.2.1.	NOTED ON SHEET A1.10
Paints and coatings. Paints and coatings shall comply with VOC limits per CGC 4.504.2.2.	NOTED ON SHEET A1.10
Aerosol paints and coatings. Aerosol paints and coatings shall meet the Product-weighted MIR limits for ROC and other requirements per CGC 4.504.2.3.	NOTED ON SHEET A1.10
Verification. Documentation will be provided, at the request of the Building Division, to verify compliance with VOC finish materials per CGC 4.504.2.4.	NOTED ON SHEET A1.10
Carpet systems. All carpet installed in the building interior shall meet the testing and product requirement per CGC 4.504.3. Carpet cushion and adhesive also must comply.	NOTED ON SHEET A1.10
Resilient flooring systems. Where resilient flooring is installed, at least 80% of flooring must comply with one of the following: the VOC-emission limits defined in the 2012 CHPS criteria and listed on its High Performance Products Database; products certified under UL Greenguard Gold program; certified under the Resilient Floor Covering Institute FloorScore program; or meet California Department of Public Health 2010 Specifications per CGC 4.504.4.	NOTED ON SHEET A1.10
Composite wood products. Hardwood plywood, particleboard and medium density fiberboard composite wood products used on the interior and exterior of the building shall comply with the low formaldehyde emission standards per CGC 4.504.5.	NOTED ON SHEET A1.10
Documentation. Verification of compliance with this section shall be provided at the request of the enforcing agency.	NOTED ON SHEET A1.10
INTERIOR MOISTURE CONTROL (CGC 4.505)	
Concrete slab foundations. A capillary break shall be installed if a slab on grade foundation system is used. The use of a 4" thick base of 1/2" or larger clean aggregate under a 6 mil vapor retarder with joint lapped not less than 6" will be provided per CGC 4.505.2 and CRC R506.2.3.	NA
Moisture content of building materials. Building materials with visible signs of water damage shall not be installed. Wall and floor framing shall not be enclosed when the framing members exceed 19% moisture content. Moisture content shall be checked prior to finish material being applied per CGC 4.505.3.	NOTED ON SHEET A1.10
INDOOR AIR QUALITY AND EXHAUST (CGC 4.506)	
Bathroom exhaust fans. ENERGY STAR compliant exhaust fans shall be provided in every bathroom per CGC 4.506.1. Fans shall be ducted to the outside and must be controlled by a humidity control, unless functioning as part of a whole house ventilation system.	NA
ENVIRONMENTAL COMFORT (CGC 4.507)	
Heating and air conditioning. Heating and air-conditioning system shall be sized, designed and have their equipment selected using the following methods: 1. Heat Loss/Heat Gain values in accordance with ANSI/ACCA 2 Manual J-2016 or equivalent; 2. Duct systems are sized according to ANSI/ACCA 1, Manual D-2016 or equivalent; 3. Select heating and cooling equipment in accordance with ANSI/ACCA 3, Manual S-2014 or equivalent.	NA
INSTALLER AND SPECIAL INSPECTOR QUALIFICATIONS	
HVAC INSTALLER QUALIFICATION (CGC 702)	
HVAC installer training. HVAC system installers shall be trained and certified in the proper installation of HVAC systems and equipment by a recognized training or certification program per CGC 702.1.	NA
VERIFICATION (CGC 703)	
Compliance documentation. Upon request, verification of compliance with this code may include construction documents, plans, specifications, builder or installer certification, inspection reports, or other methods acceptable to the building department which will show substantial conformance.	NOTED ON SHEET G1.1, SECTION 703.1

Responsible Designer's Declaration Statement	Contractor's Declaration Statement
I hereby certify that this project has been designed to meet the requirements of the 2019 California Green Building Standards Code.	I hereby certify, as the building or installer under permit listed herein, that this project will be constructed to meet the requirements of the 2019 California Green Building Standards Code.
Name: PETER CHRISTOPHER KLIMEN	Name:
Signature: <i>Peter Christopher Klimen</i>	Signature:
Date: 2/16/20	Date:
Company: CHRIS KLIMEN CAD SERVICES	Company:
Address: 1215 SUMMIT LAKE DR	Address:
City/St/Zip: ANGWIN, CA 94508	City/St/Zip:

Revision History	
	AS-BUILT
	PRELIMINARY DESIGN
	DESIGN
	PERMIT SET
1	PLAN REVIEW COMMENTS
2	PLAN REVIEW COMMENTS

REMODEL & ADDITION	OWNER:
--------------------	--------

Drawing By:
Chris Klimen
klimen@att.net
PH: 510.928.1359
<i>Peter Christopher Klimen</i> <small>DIGITALLY SIGNED BY PETER CHRISTOPHER KLIMEN EMAIL: KLIMEN@ATT.NET DATE: 000000</small>

CAL GREEN CHECKLIST

G1.2

CONSTRUCTION NOTES:

- SEE SHEETS A0.2, G1.0 & G1.1 FOR MANDATORY GENERAL CONSTRUCTION, ELECTRICAL, MECHANICAL, & PLUMBING REQUIREMENTS
- ANNULAR SPACES AROUND PIPES, ELECTRIC CABLES, CONDUITS OR OTHER OPENINGS IN SOLE/BOTTOM PLATES AT EXTERIOR WALLS SHALL BE PROTECTED AGAINST THE PASSAGE OF RODENTS BY CLOSING SUCH OPENINGS WITH CEMENT MORTAR, CONCRETE MASONRY OR A SIMILAR METHOD ACCEPTABLE TO THE ENFORCING AGENCY.
- CONTRACTORS SHALL PROVIDE OWNER WITH ALL END USER INFORMATION & MAINTENANCE MANUALS FOR INSTALLED ITEMS & ALL OTHER REQUIRED INFORMATION DESCRIBED IN SECTION 4.410 ON SHEET G1.0 PRIOR TO BUILDING FINAL
- ALL FINISH MATERIALS SHALL BE COMPLIANT WITH VOC AND OTHER TOXIC COMPOUND LIMITS AS OUTLINED IN SECTION 4.504 ON SHEETS G1.0 & G1.1. INCLUDING (BUT NOT LIMITED TO) ADHESIVES, SEALANTS, CAULKS, PAINTS, STAINS, COATINGS, CARPET & CARPET SYSTEMS, RESILIENT FLOORING, PARTICLEBOARD, MEDIUM DENSITY FIBERBOARD, PLYWOOD. DOCUMENTATION IS REQUIRED AS SPECIFIED IN SECTION 4.504.2.4 ON SHEET G1.0
- MOISTURE CONTENT OF BUILDING MATERIALS SHALL BE VERIFIED AND DOCUMENTATION PROVIDED TO THE ENFORCING AGENCY AS OUTLINED IN SECTION 4.505.3 ON SHEET G1.1. DO NOT CLOSE ANY CONSTRUCTION PRIOR TO VERIFICATION
- ALL DUCT AND OTHER RELATED AIR DISTRIBUTION COMPONENT OPENINGS SHALL BE COVERED WITH TAPE, PLASTIC, SHEET METAL OR OTHER METHODS ACCEPTABLE TO THE ENFORCING AGENCY TO REDUCE THE AMOUNT OF WATER, DUST OR DEBRIS WHICH MAY ENTER THE SYSTEM.

SCOPE OF WORK:


- DASHED LINES REPRESENT ITEMS TO BE REMOVED
- REPLACE EXISTING CABINETS WITH NEW
- INSTALL NEW SINK & SINK FIXTURE. CONNECT SINK TO EXISTING UTILITIES – SEE SHEET G1.0, SECTION 4.303.2 FOR CAL GREEN KITCHEN FIXTURE REQUIREMENTS
- INSTALL NEW COUNTER TOP
- INSTALL NEW RANGE, HOOD, DISHWASHER, & REFRIGERATOR. CONNECT TO EXISTING UTILITIES.
- EXISTING WINDOWS TO REMAIN
- EXISTING DOORS TO REMAIN
- EXISTING RECEPTACLES TO REMAIN
- REMOVE EXISTING CEILING FAN
- TOUCH UP PAINT AS NEEDED

MECHANICAL NOTES:


- SEE "MECHANICAL NOTES" ON SHEET A0.2 FOR ADDITIONAL MECHANICAL REQUIREMENTS.
- NEW HOOD VENT DUCT SHALL BE OF METAL AND SHALL HAVE SMOOTH INTERIOR SURFACES. ALUMINUM FLEX DUCT IS NOT ALLOWED.
- KITCHEN RANGE HOODS REQUIRE MINIMUM VENTILATION PER 2016 ASHRAE 62.2, SECTION 5 (SECTION 150.0(O)2B) AND MAXIMUM SOUND RATING PER 2016 ASHRAE 62.2, SECTION 7.2 (SECTION 150.0(O)1G)
 - THIS CORRESPONDS TO 100 CFM VENTILATION FOR MOST KITCHENS AND A SOUND RATING OF THREE SONES OR LESS
 - A HERS RATER MUST VERIFY THAT INSTALLED RANGE HOODS ARE LISTED IN THE HVI CERTIFIED HOME VENTILATING PRODUCTS DIRECTORY AND HAVE BEEN HVI-CERTIFIED AS MEETING ASHRAE 62.2 VENTILATION AND SOUND REQUIREMENTS

- (E) = EXISTING
- (N) = NEW
- (R) = RELOCATE


- SURFACE MOUNTED LIGHT FIXTURE
- GFCI RECEPTACLE
- RECEPTACLE

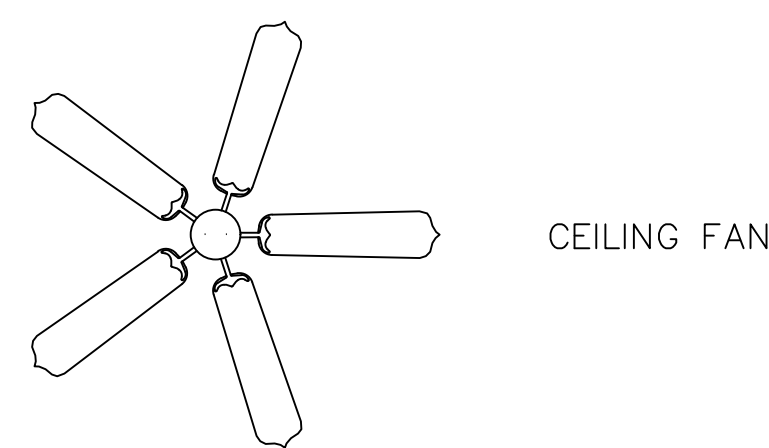


CEILING FAN

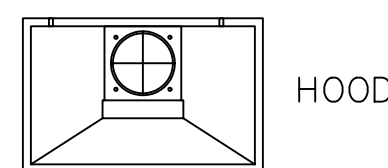


HOOD

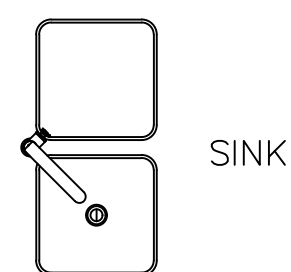

SINK

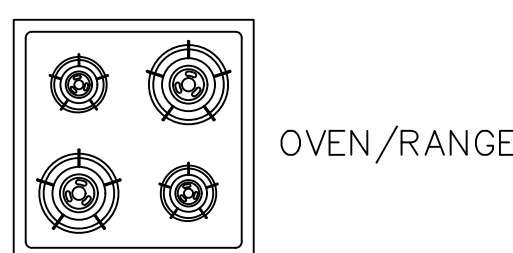

OVEN/RANGE

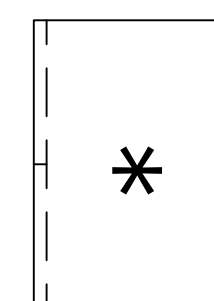


REFRIGERATOR




DISHWASHER

LEGEND:


	EXISTING TO REMAIN
	EXISTING TO BE REMOVED U.O.N.

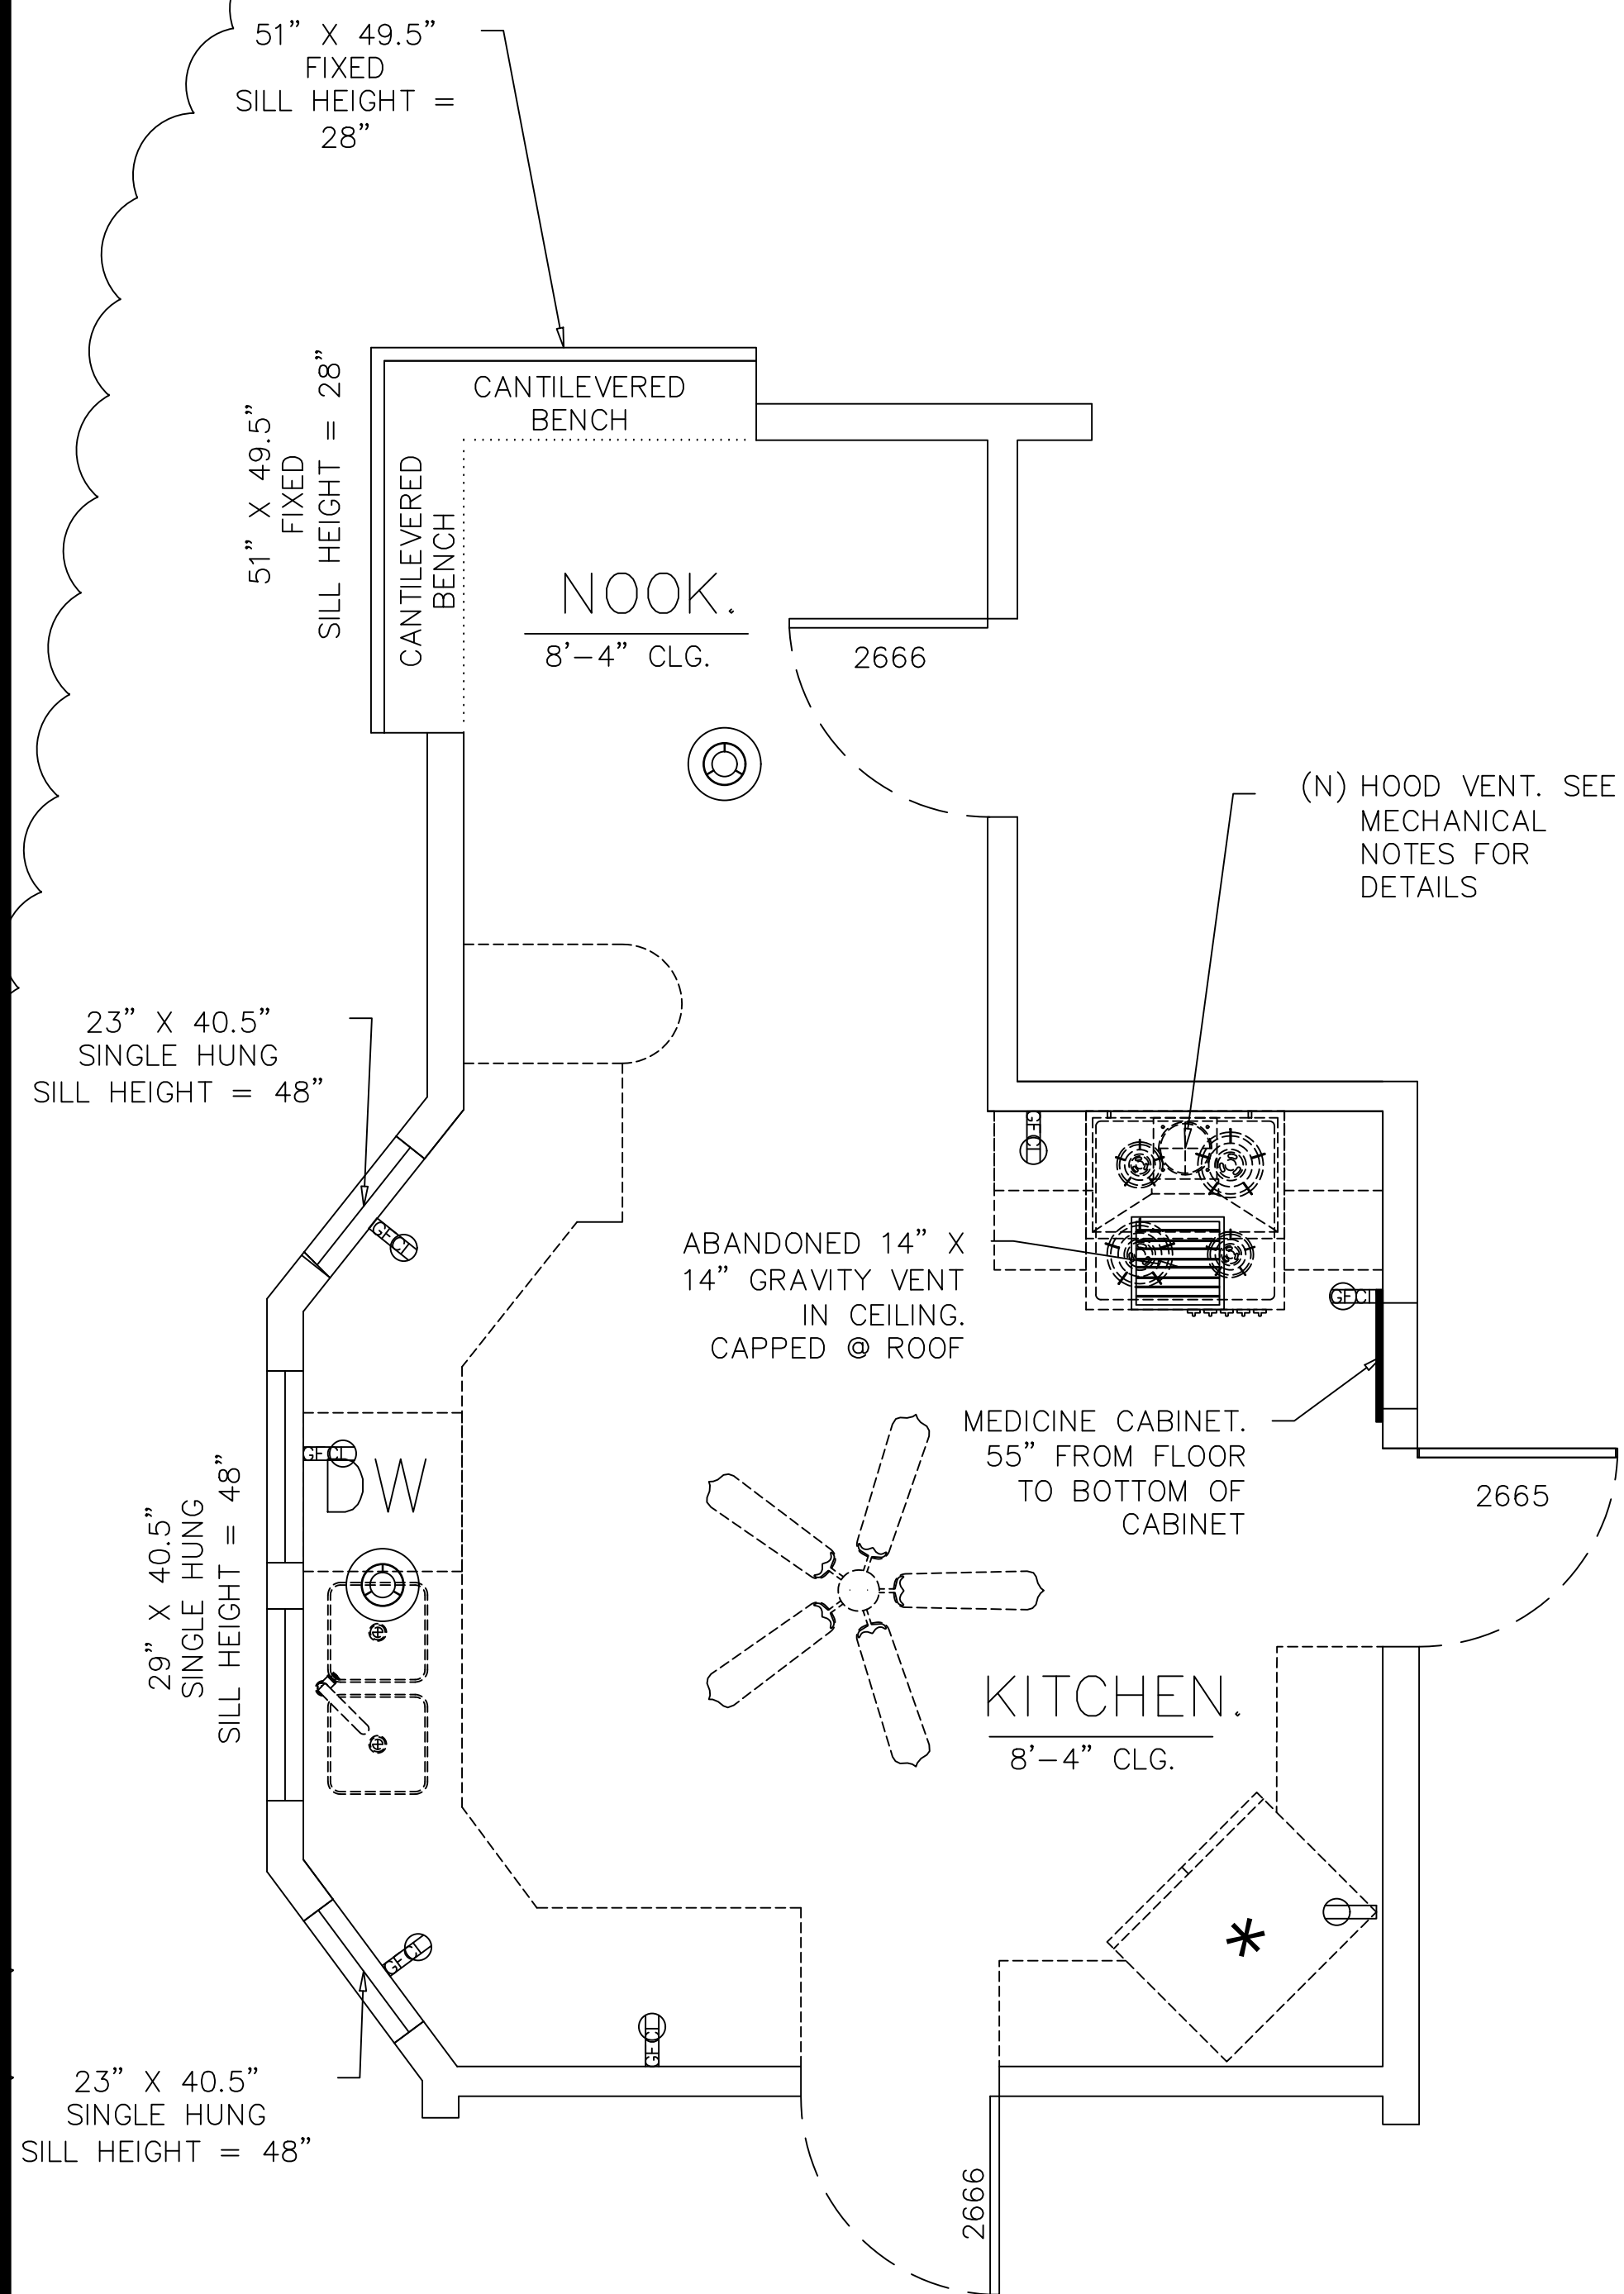

(E) FLOOR PLAN

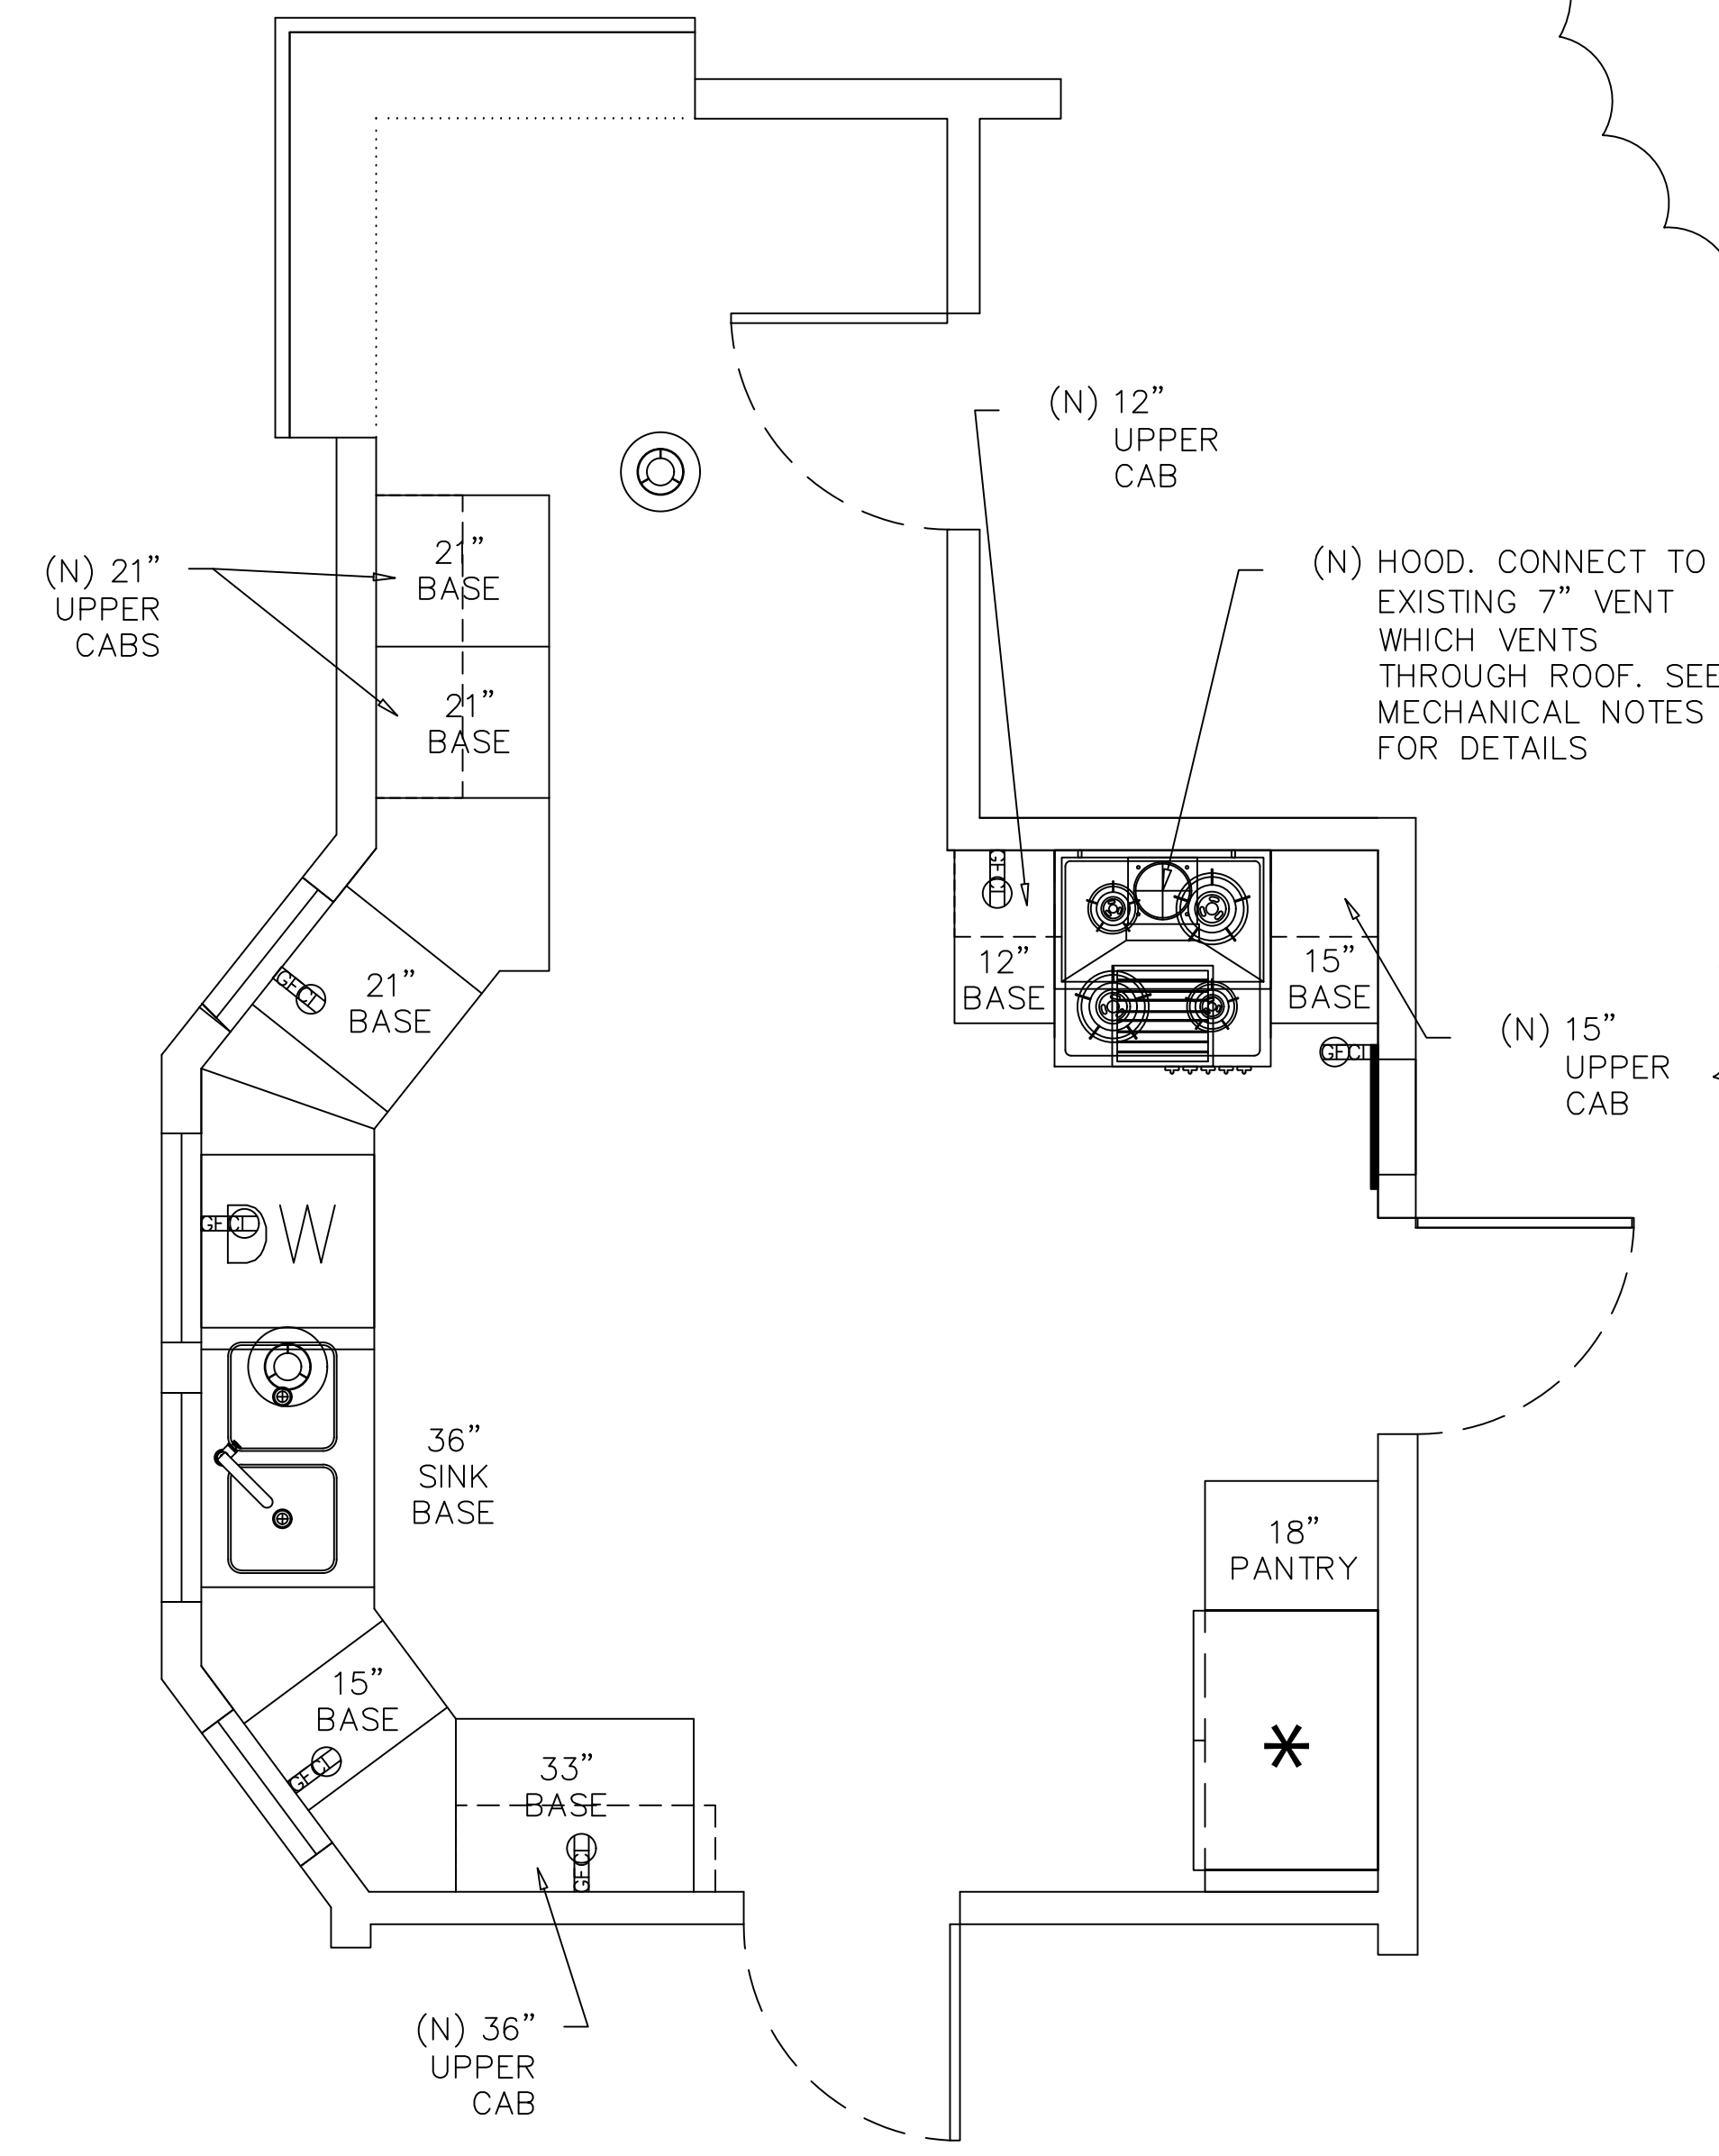

(N) FLOOR PLAN

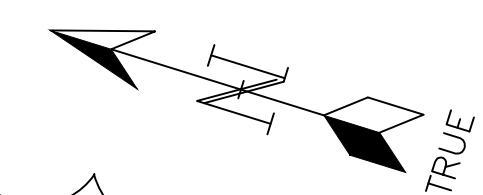

(E) ENLARGED FLOOR PLAN
SCALE: 1/2" = 1'-0"

Revision History

	AS-BUILT
	PRELIMINARY DESIGN
	DESIGN
	PERMIT SET
1	PLAN REVIEW COMMENTS
2	PLAN REVIEW COMMENTS

REMODEL & ADDITION

OWNER:

Drawing By:

Chris Klimen

klimen@att.net


PH: 510.928.1359

Peter Christopher Klimen


DIGITALLY SIGNED BY PETER CHRISTOPHER KLIMEN
EMAIL: KLIMEN@ATT.NET DATE: 00/00/00

ENLARGED FLOOR PLAN & DEMOLITION PLAN

A1.10

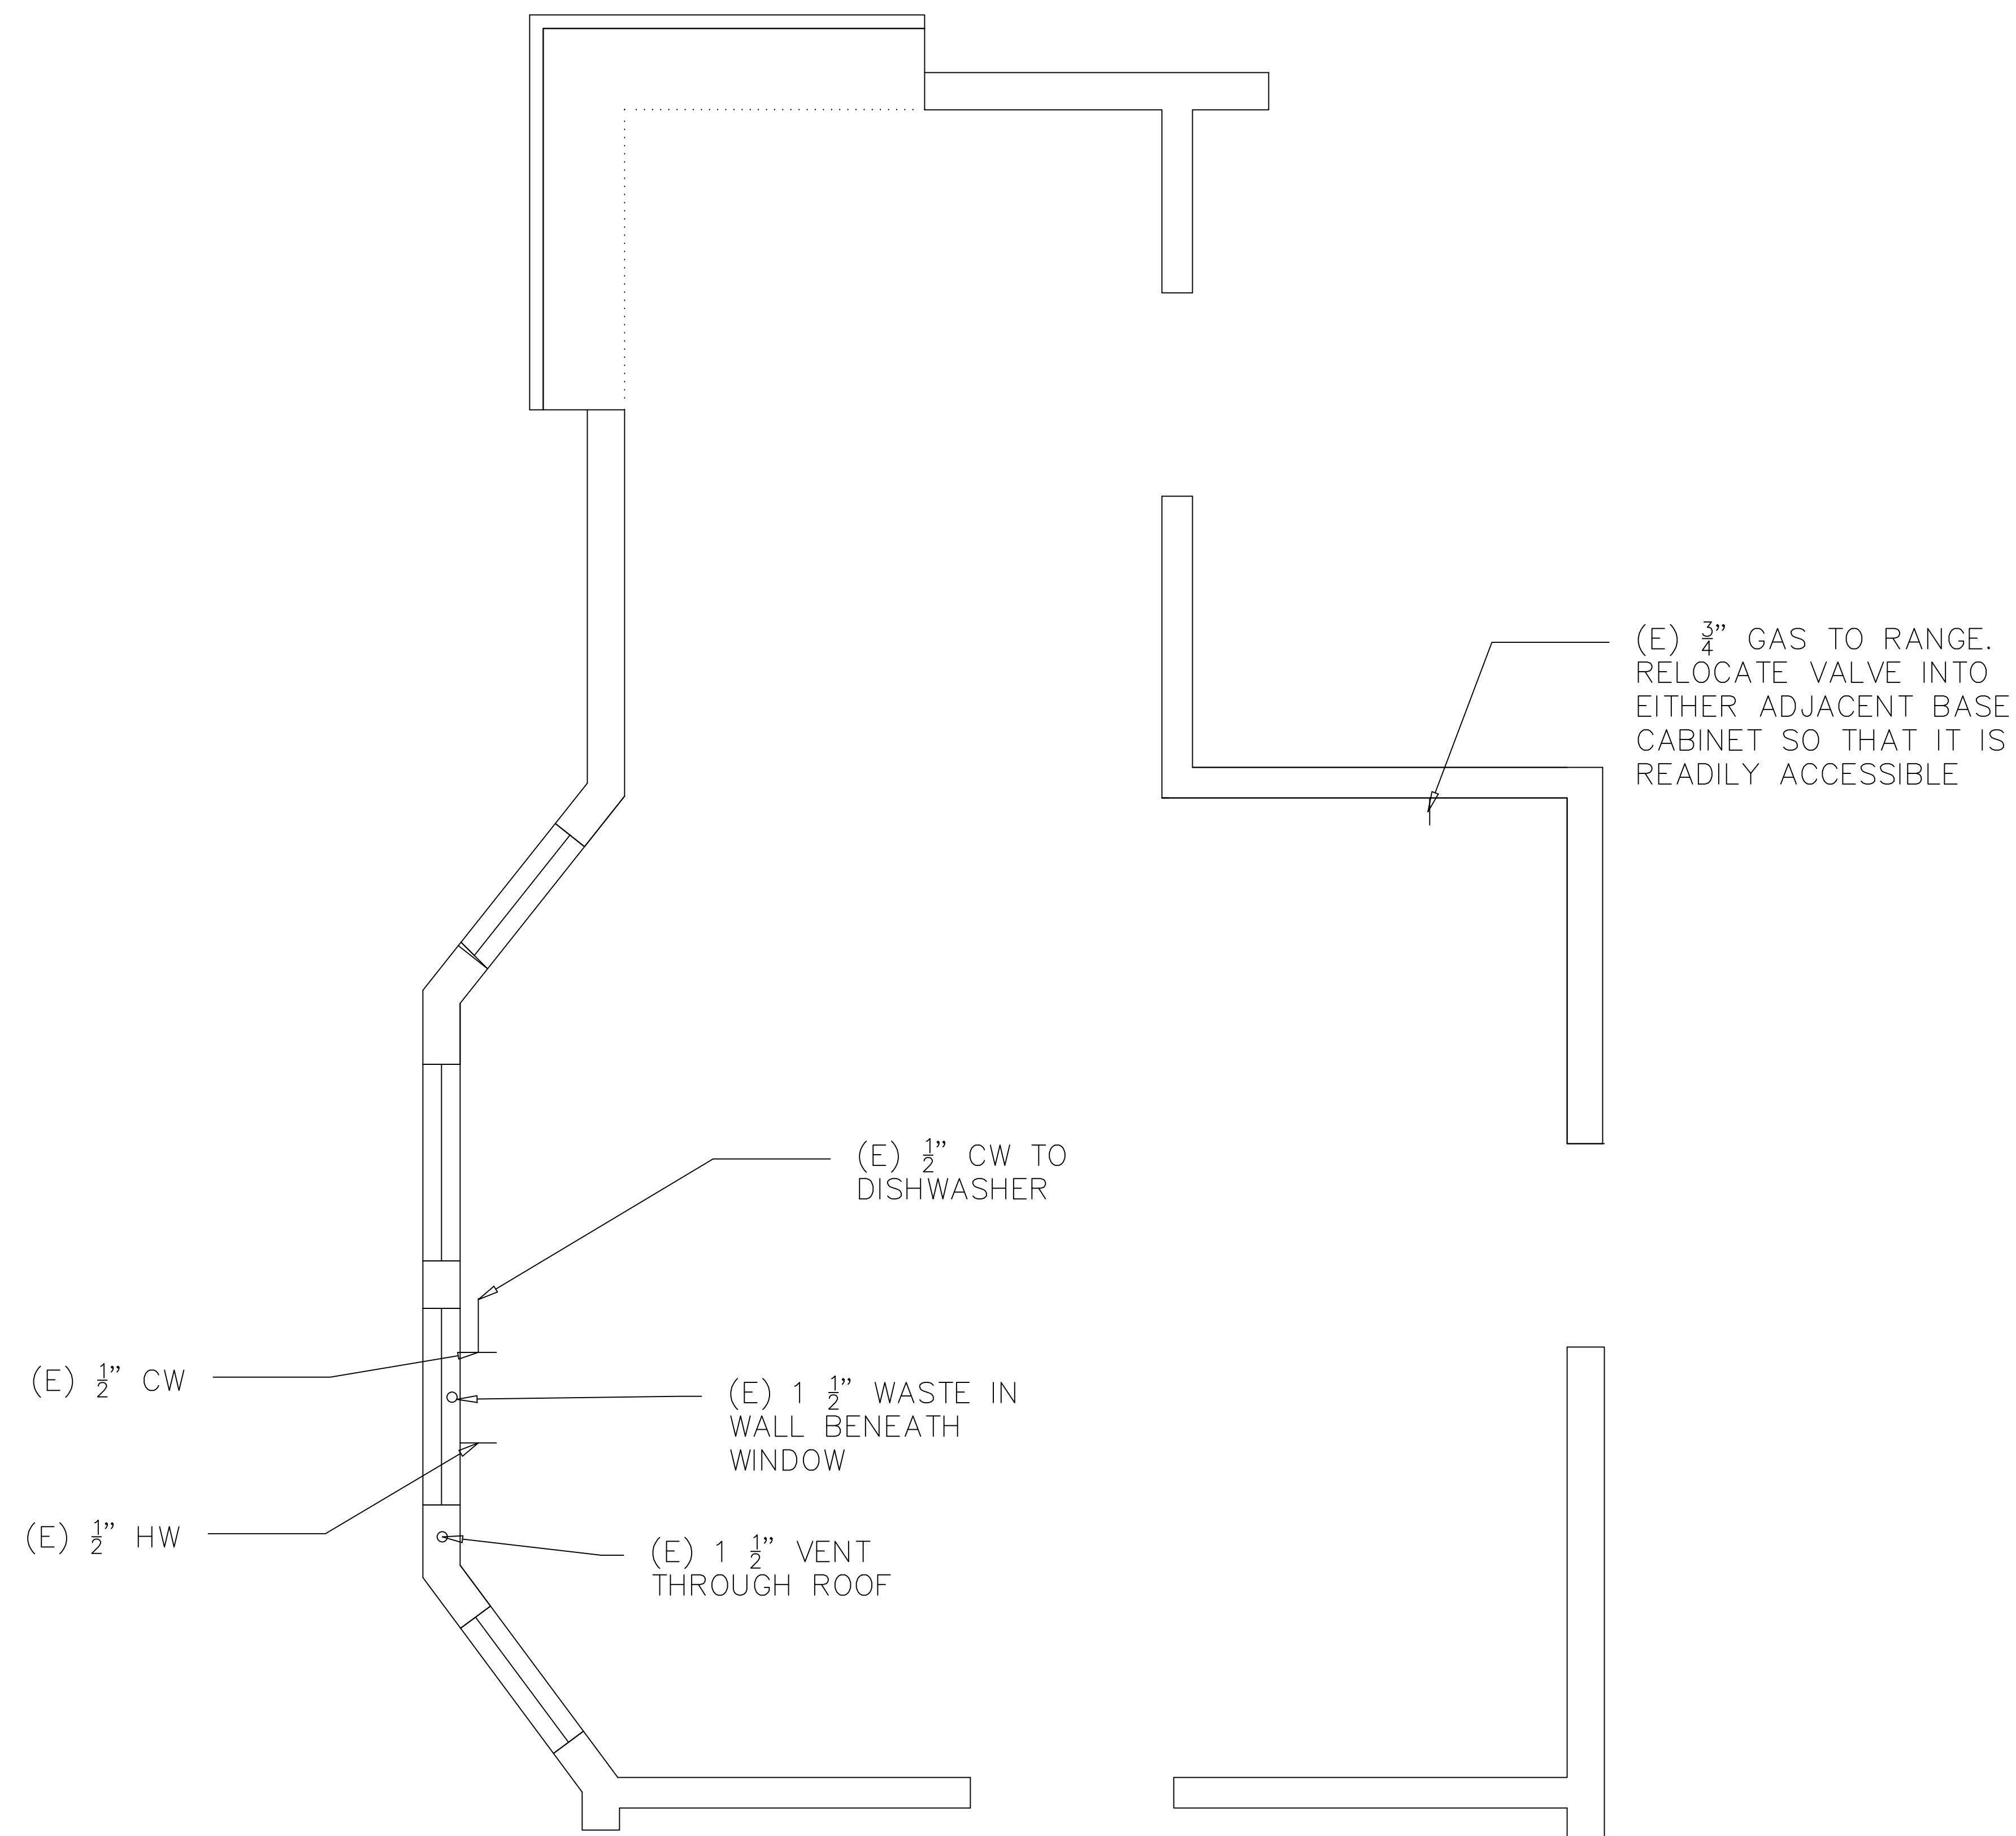

Revision History	
	AS-BUILT
	PRELIMINARY DESIGN
	DESIGN
	PERMIT SET
1	PLAN REVIEW COMMENTS
2	PLAN REVIEW COMMENTS

 


REMODEL & ADDITION	OWNER:
--------------------	--------

Drawing By:
 Chris Klimen
 klimen@att.net
 PH: 510.928.1359


Peter Christopher Klimen
DIGITALLY SIGNED BY PETER CHRISTOPHER KLIMEN
 EMAIL=KLIMEN@ATT.NET DATE: 00/00/00

PLUMBING PLAN

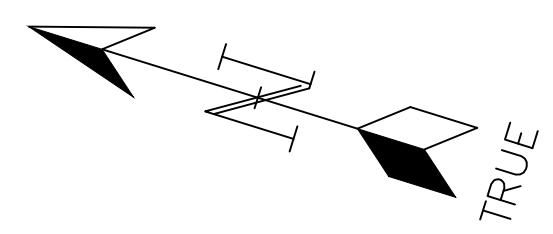

PLUMBING PLAN
 SCALE: 3/4" = 1'-0"

P1.10

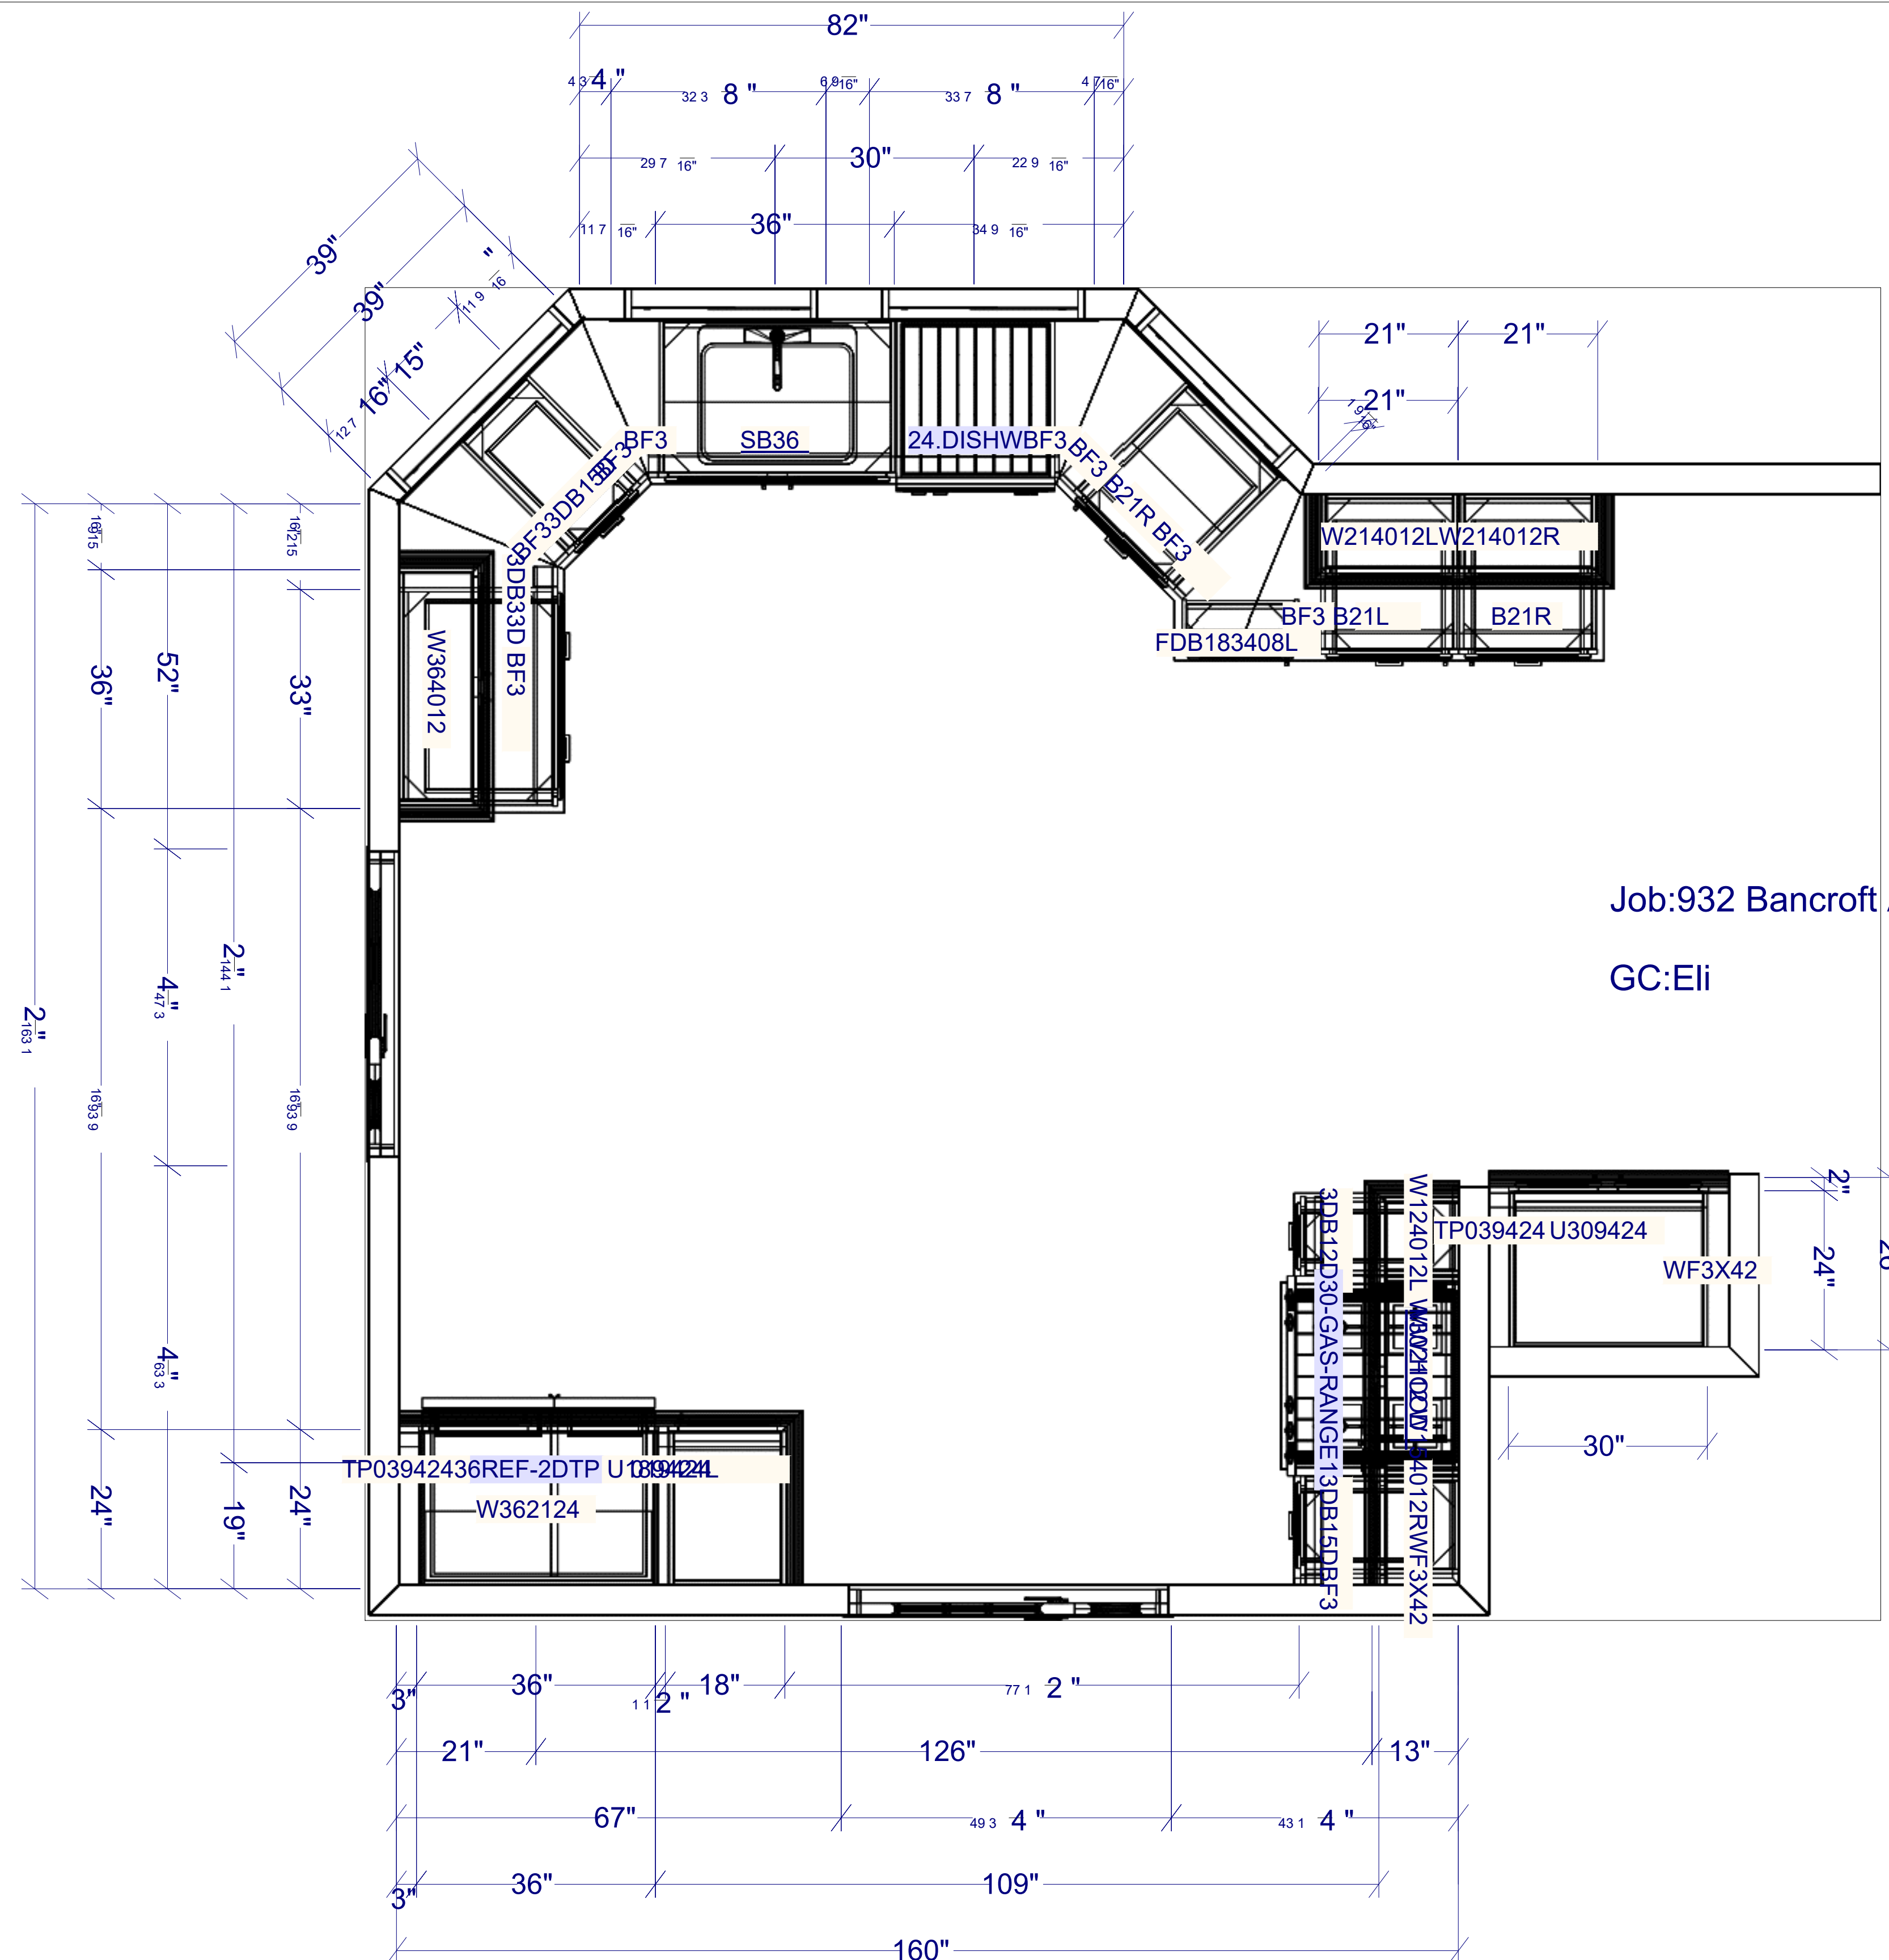

Job:932 Bancroft Ave San Leandro CA 94577

GC:Eli

All dimensions and size designations given are subject to verification on job site and adjustment to fit job conditions.
GC and owner must verify all measurement before installation



Pacific Home Decor
1500 West Winton Ave
Hayward, CA 94545
Tel: 510-732-8668
Fax: 510-732-8628
www.PacificHomeDecor.com

Designed: 1/24/2020
Printed: 1/24/2020

Jennifer Design #657 Eli 932 Bancroft Ave San Leandro G13 1209.kit

All

Drawing #: 1 No Scale.

Revision History

	AS-BUILT
	PRELIMINARY DESIGN
	DESIGN
	PERMIT SET
①	PLAN REVIEW COMMENTS
②	PLAN REVIEW COMMENTS

REMODEL & ADDITION

OWNER:

Drawing By:

Chris Klimen

klimen@att.net

PH: 510.928.1359

Peter Christopher Klimen

DIGITALLY SIGNED BY PETER CHRISTOPHER KLIMEN
EMAIL=KLIMEN@ATT.NET DATE: 00/00/00

CABINETS

A1.80

(N) CABINET PLAN
NOT TO SCALE