



SITE PLAN
SCALE: 1/8"=1'-0"

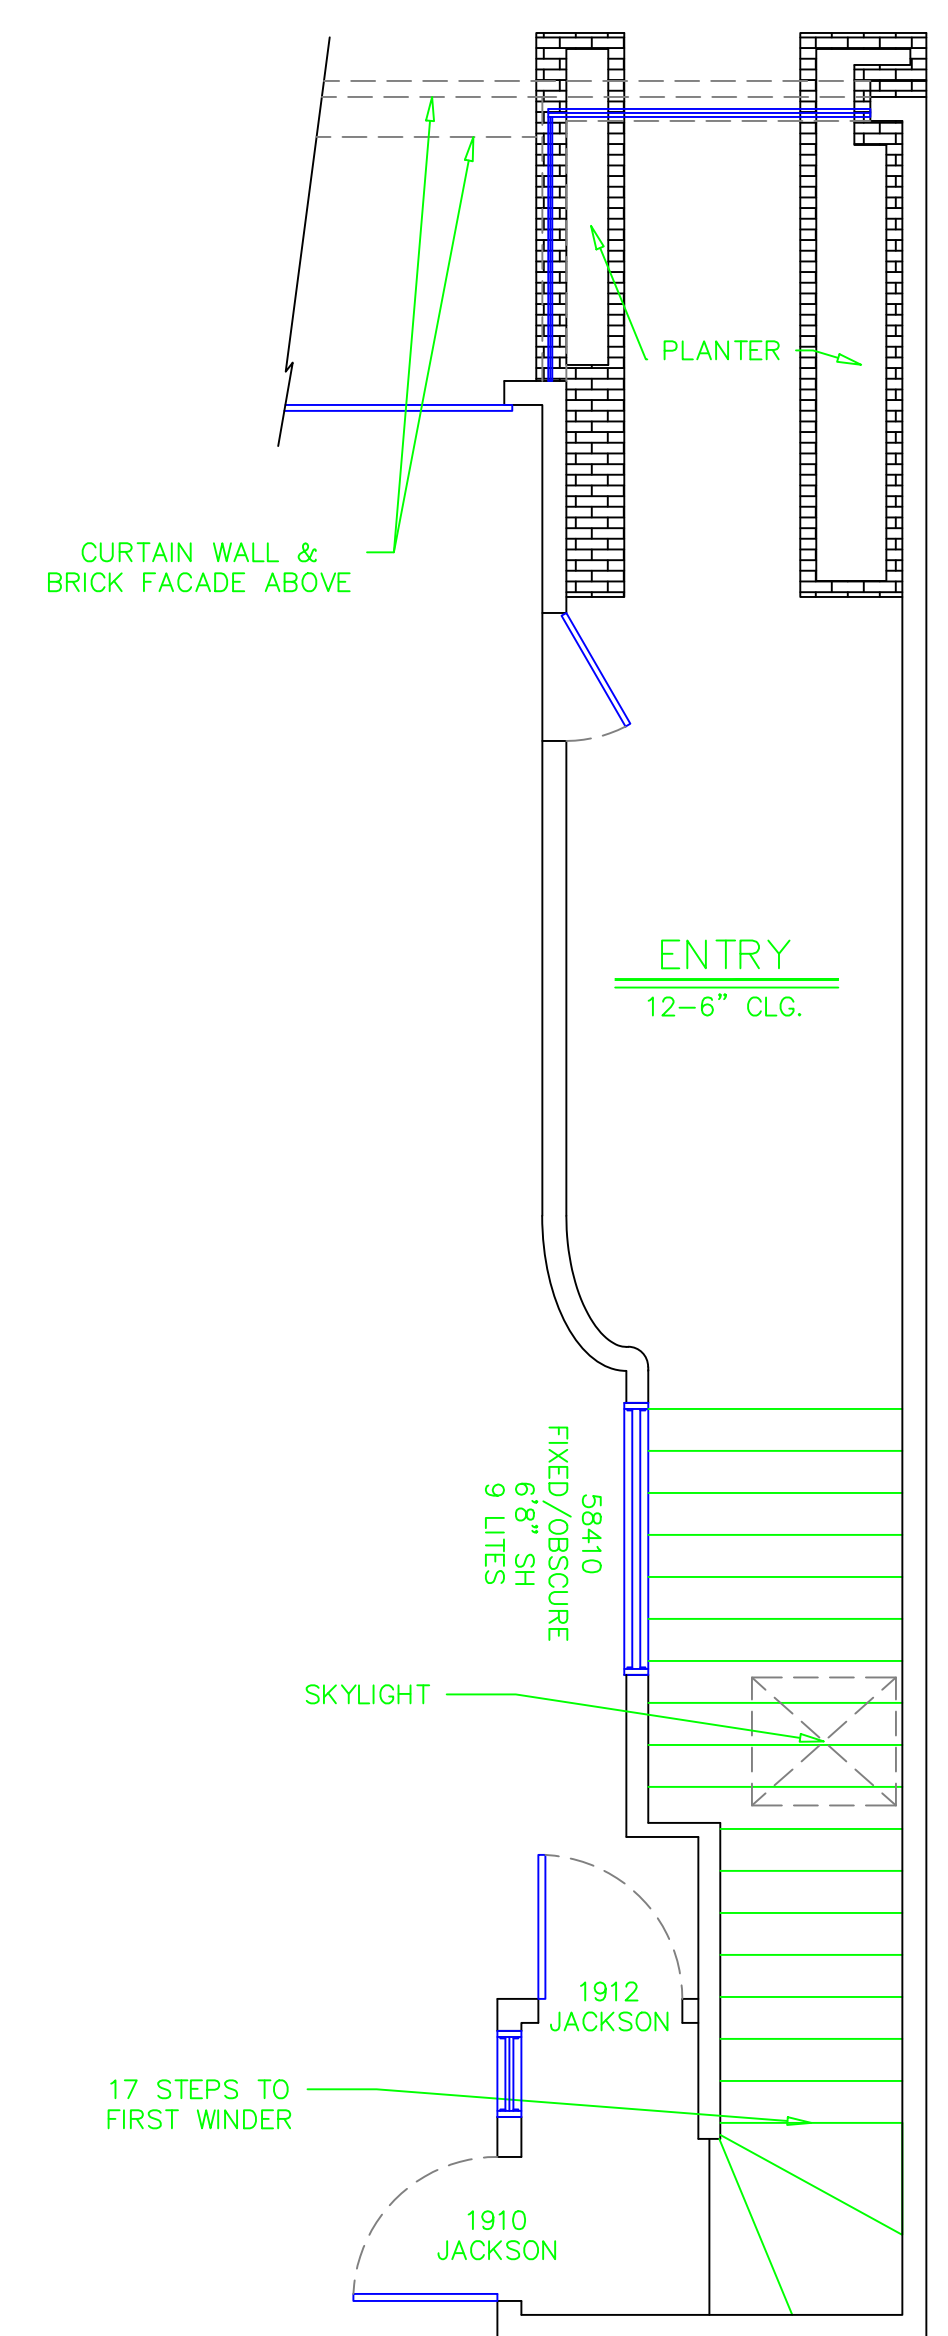

BUILDING ENTRANCE
SCALE: 1/4"=1'-0"

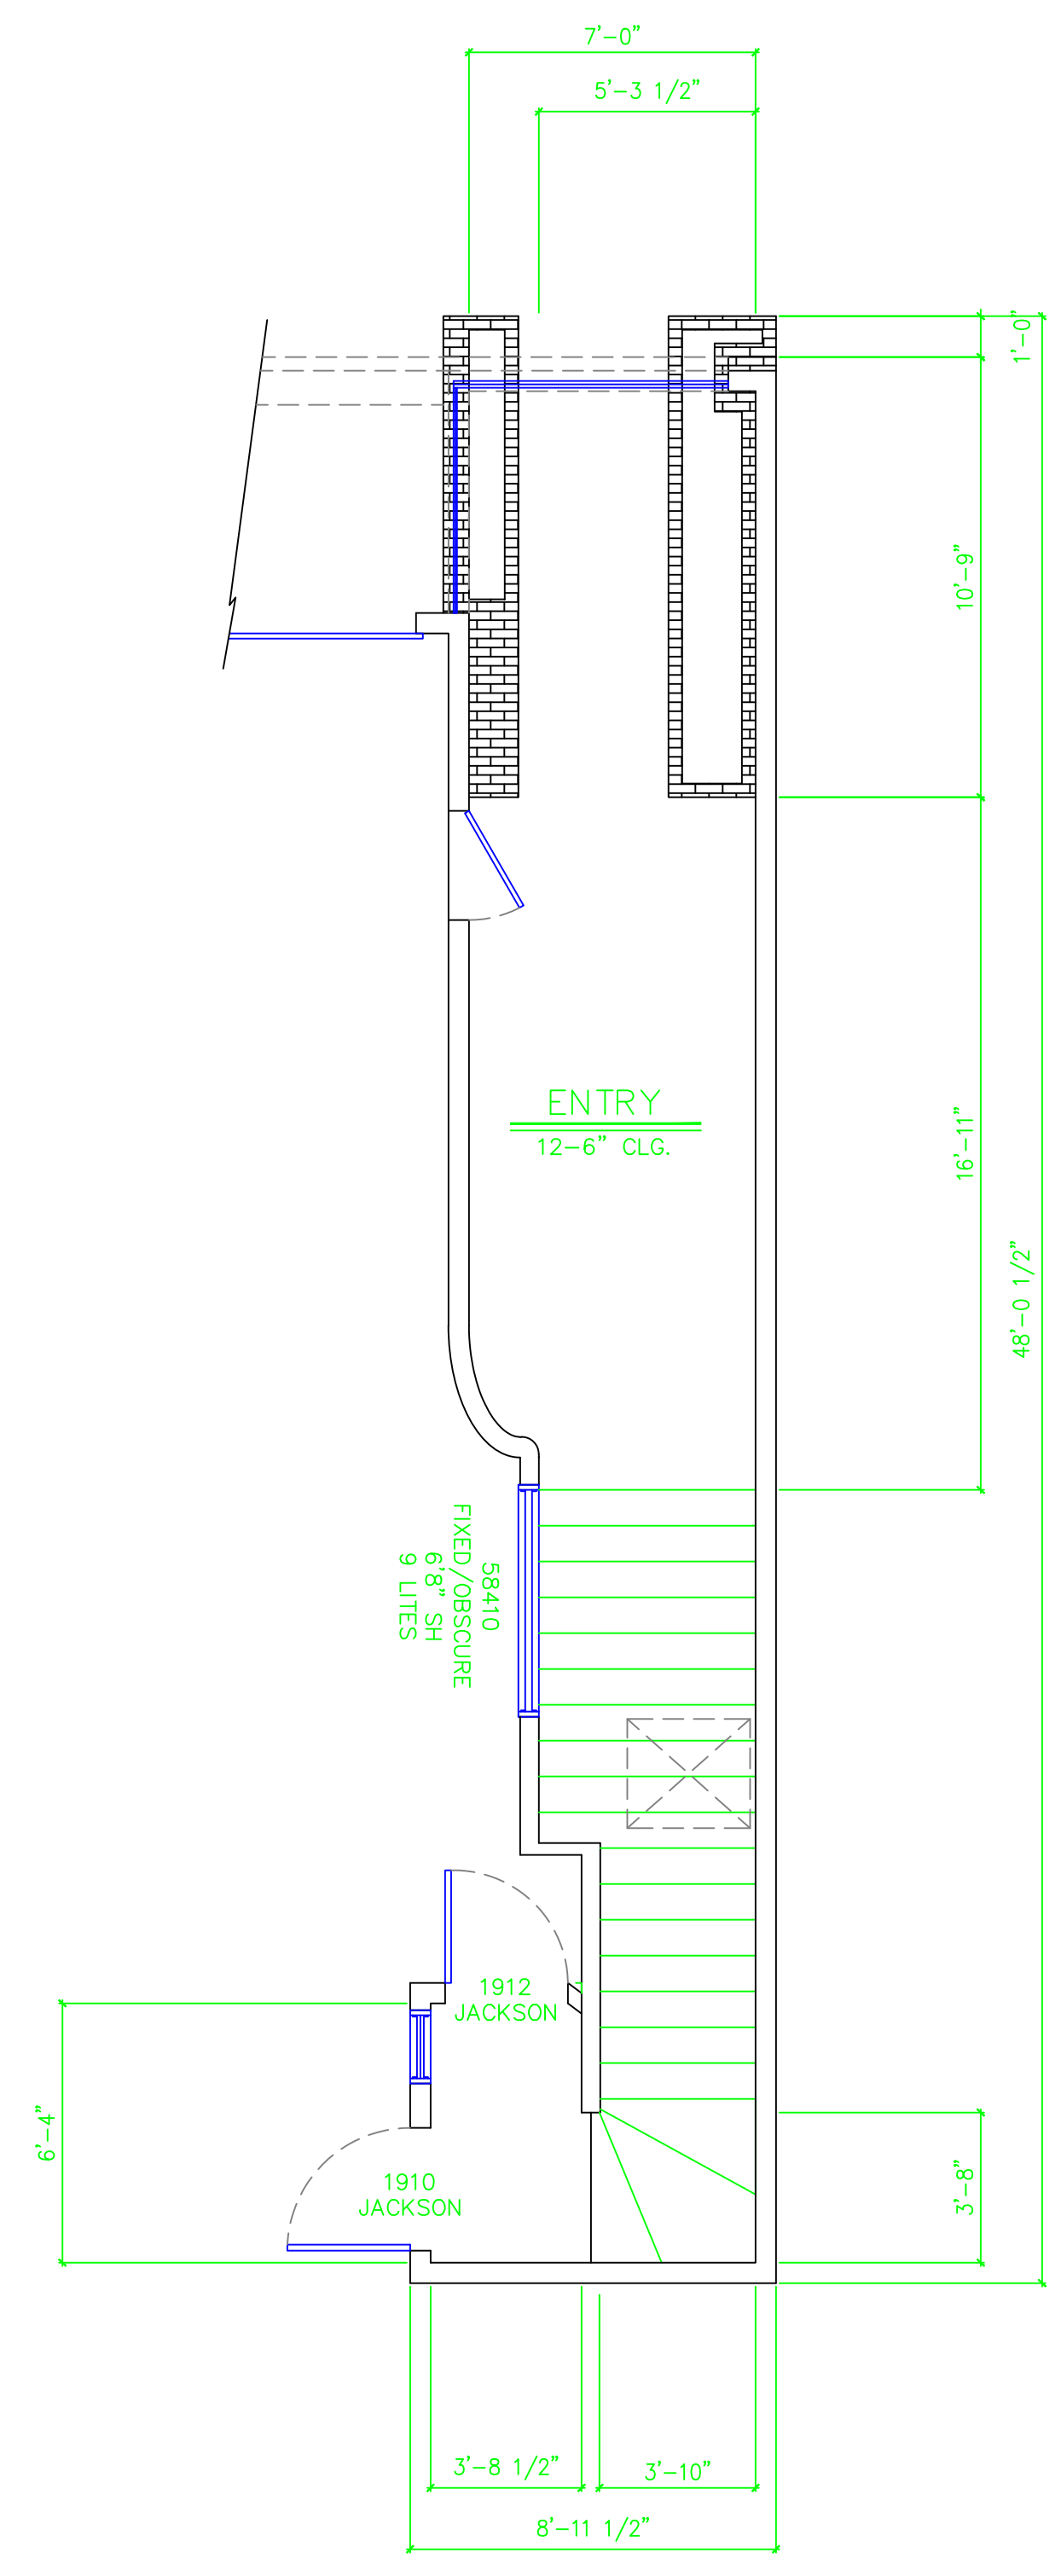

Revision History	
	AS-BUILT
	PRELIMINARY DESIGN
	DESIGN
	PERMIT SET
1	PLAN REVIEW COMMENTS
2	PLAN REVIEW COMMENTS

REMODEL & ADDITION



OWNER:

Drawing By:
Chris Klimen
klimen@att.net
PH: 510.928.1359

Peter Christopher Klimen
DIGITALLY SIGNED BY PETER CHRISTOPHER KLIMEN
EMAIL: KLIMEN@ATT.NET DATE: 000000

AS-BUILT
SITE PLAN
& ENTRANCE

SP

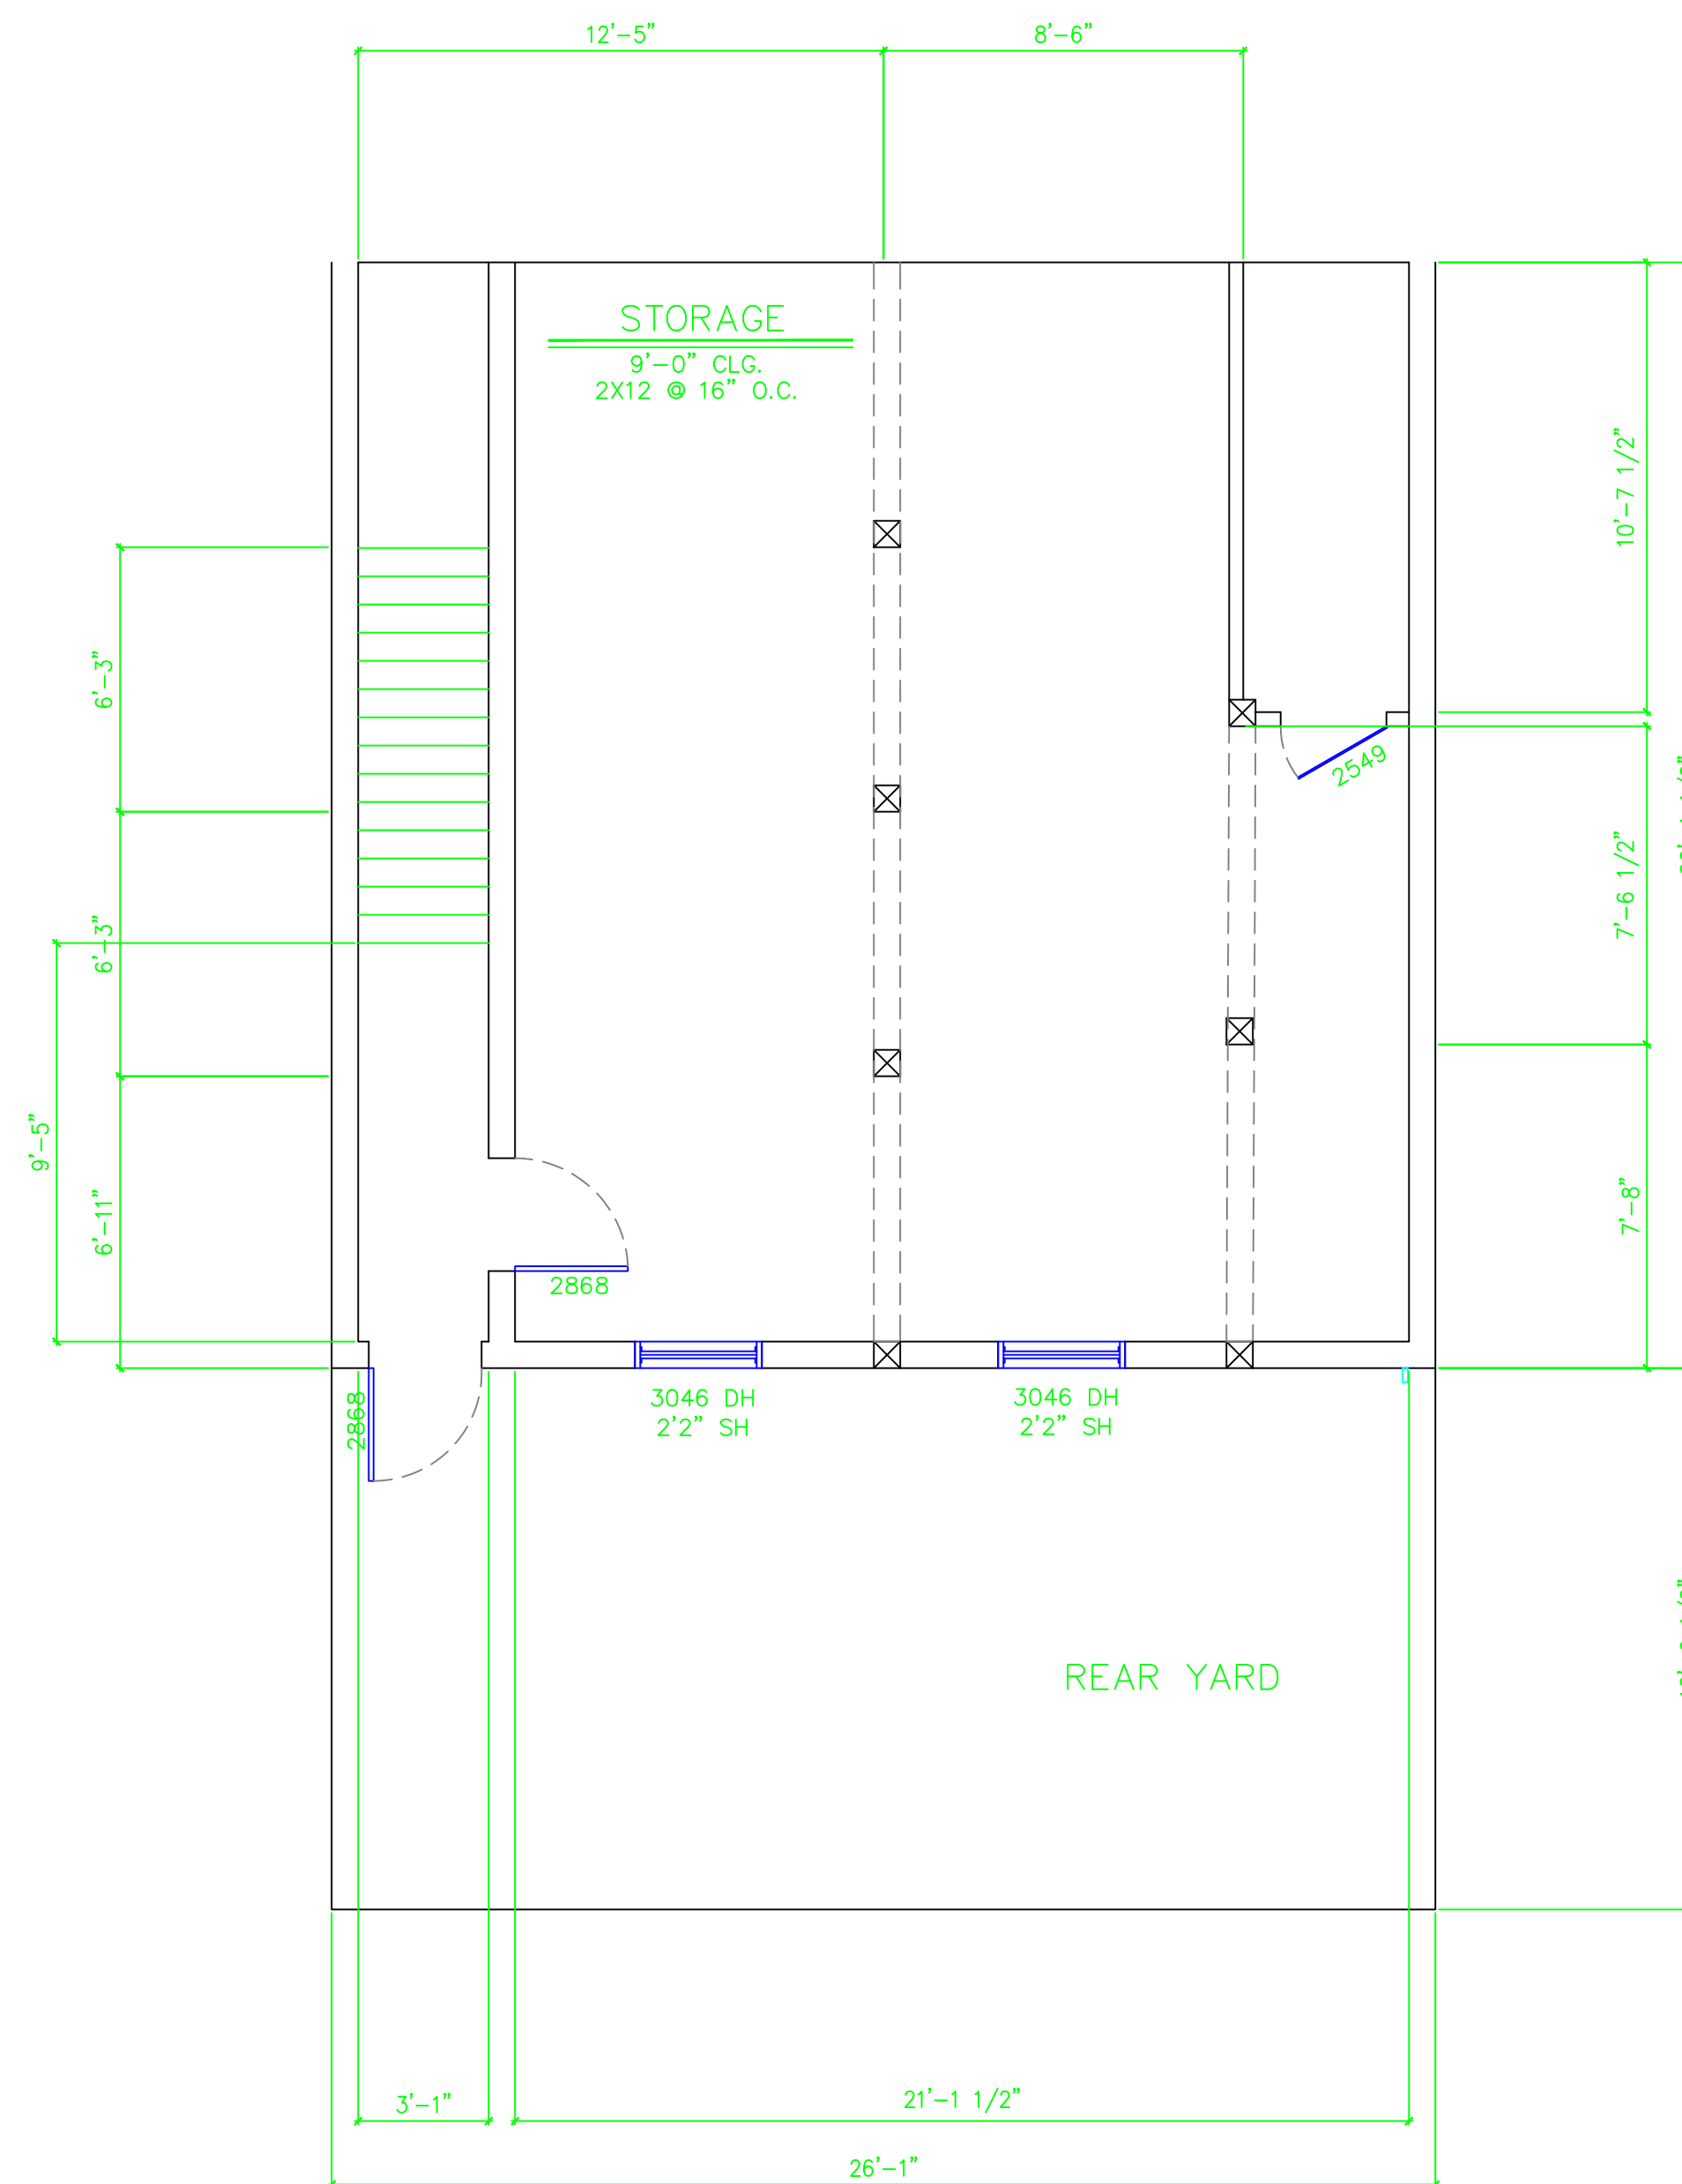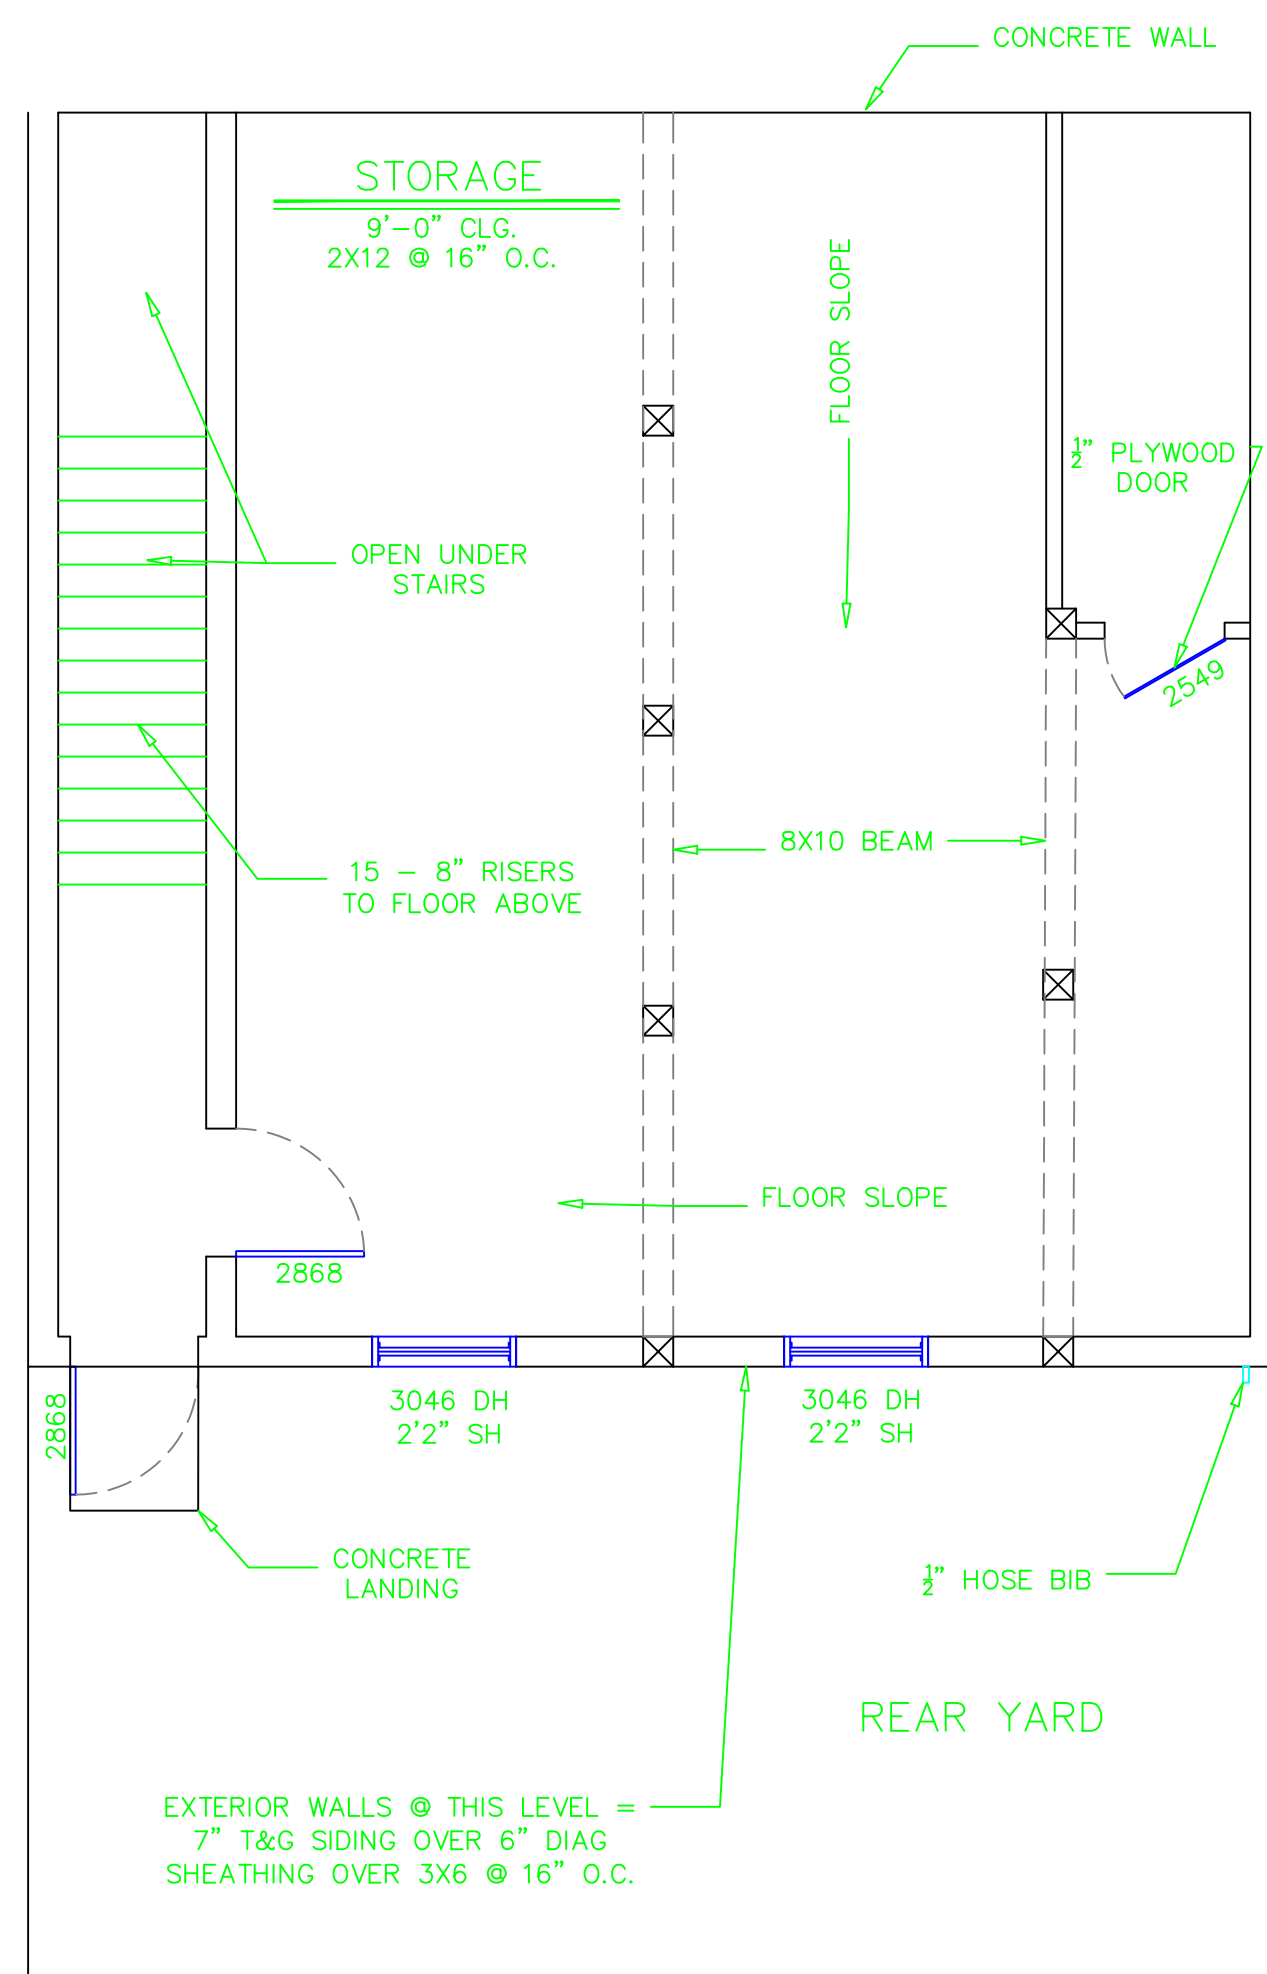

Revision History

	AS-BUILT
	PRELIMINARY DESIGN
	DESIGN
	PERMIT SET
1	PLAN REVIEW COMMENTS
2	PLAN REVIEW COMMENTS

REMODEL & ADDITION

OWNER:

Drawing By:

Chris Klimen

klimen@att.net

PH: 510.928.1359

Peter Christopher Klimen

DIGITALLY SIGNED BY PETER CHRISTOPHER KLIMEN
EMAIL: KLIMEN@ATT.NET DATE: 000000

AS-BUILT
LEVEL 1
STORAGE &
REAR YARD

AB1

STORAGE & REAR YARD
SCALE: 1/4"=1'-0"

Revision History

	AS-BUILT
	PRELIMINARY DESIGN
	DESIGN
	PERMIT SET
1	PLAN REVIEW COMMENTS
2	PLAN REVIEW COMMENTS

REMODEL & ADDITION

OWNER:

Drawing By:

Chris Klimen



klimen@att.net

PH: 510.928.1359


Peter Christopher Klimen
DIGITALLY SIGNED BY PETER CHRISTOPHER KLIMEN
 EMAIL: KLIMEN@ATT.NET DATE: 000000

AS-BUILT
 LEVEL 2
 GARAGE


AB2

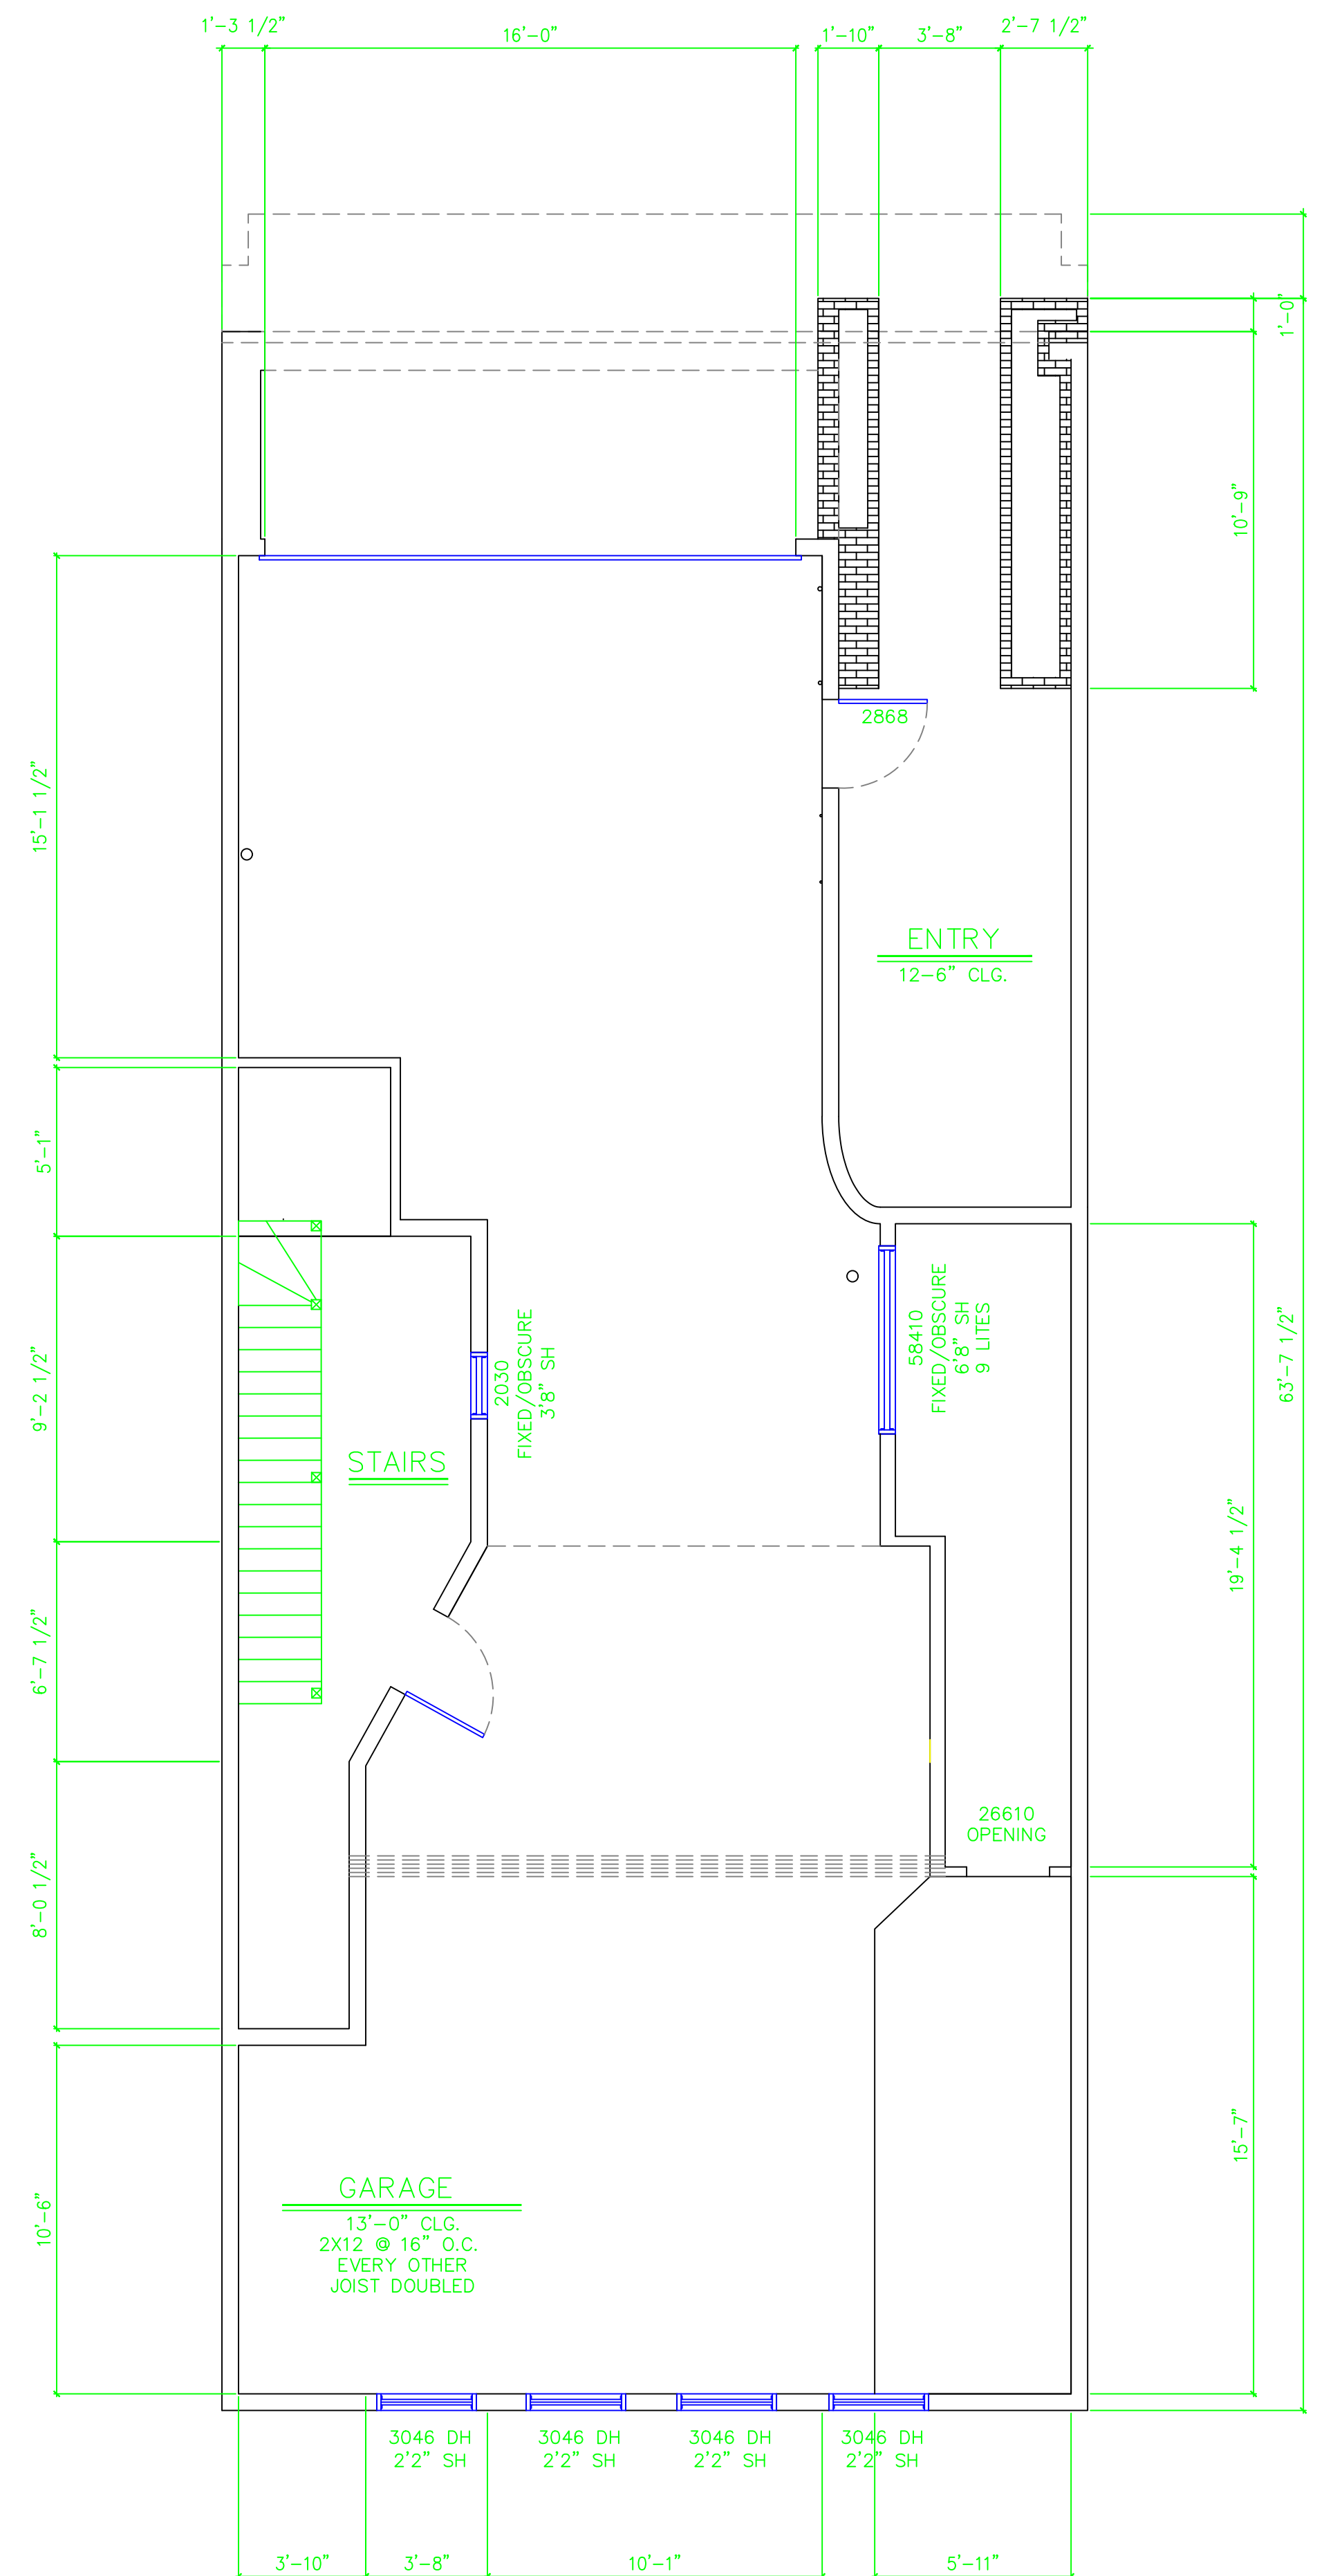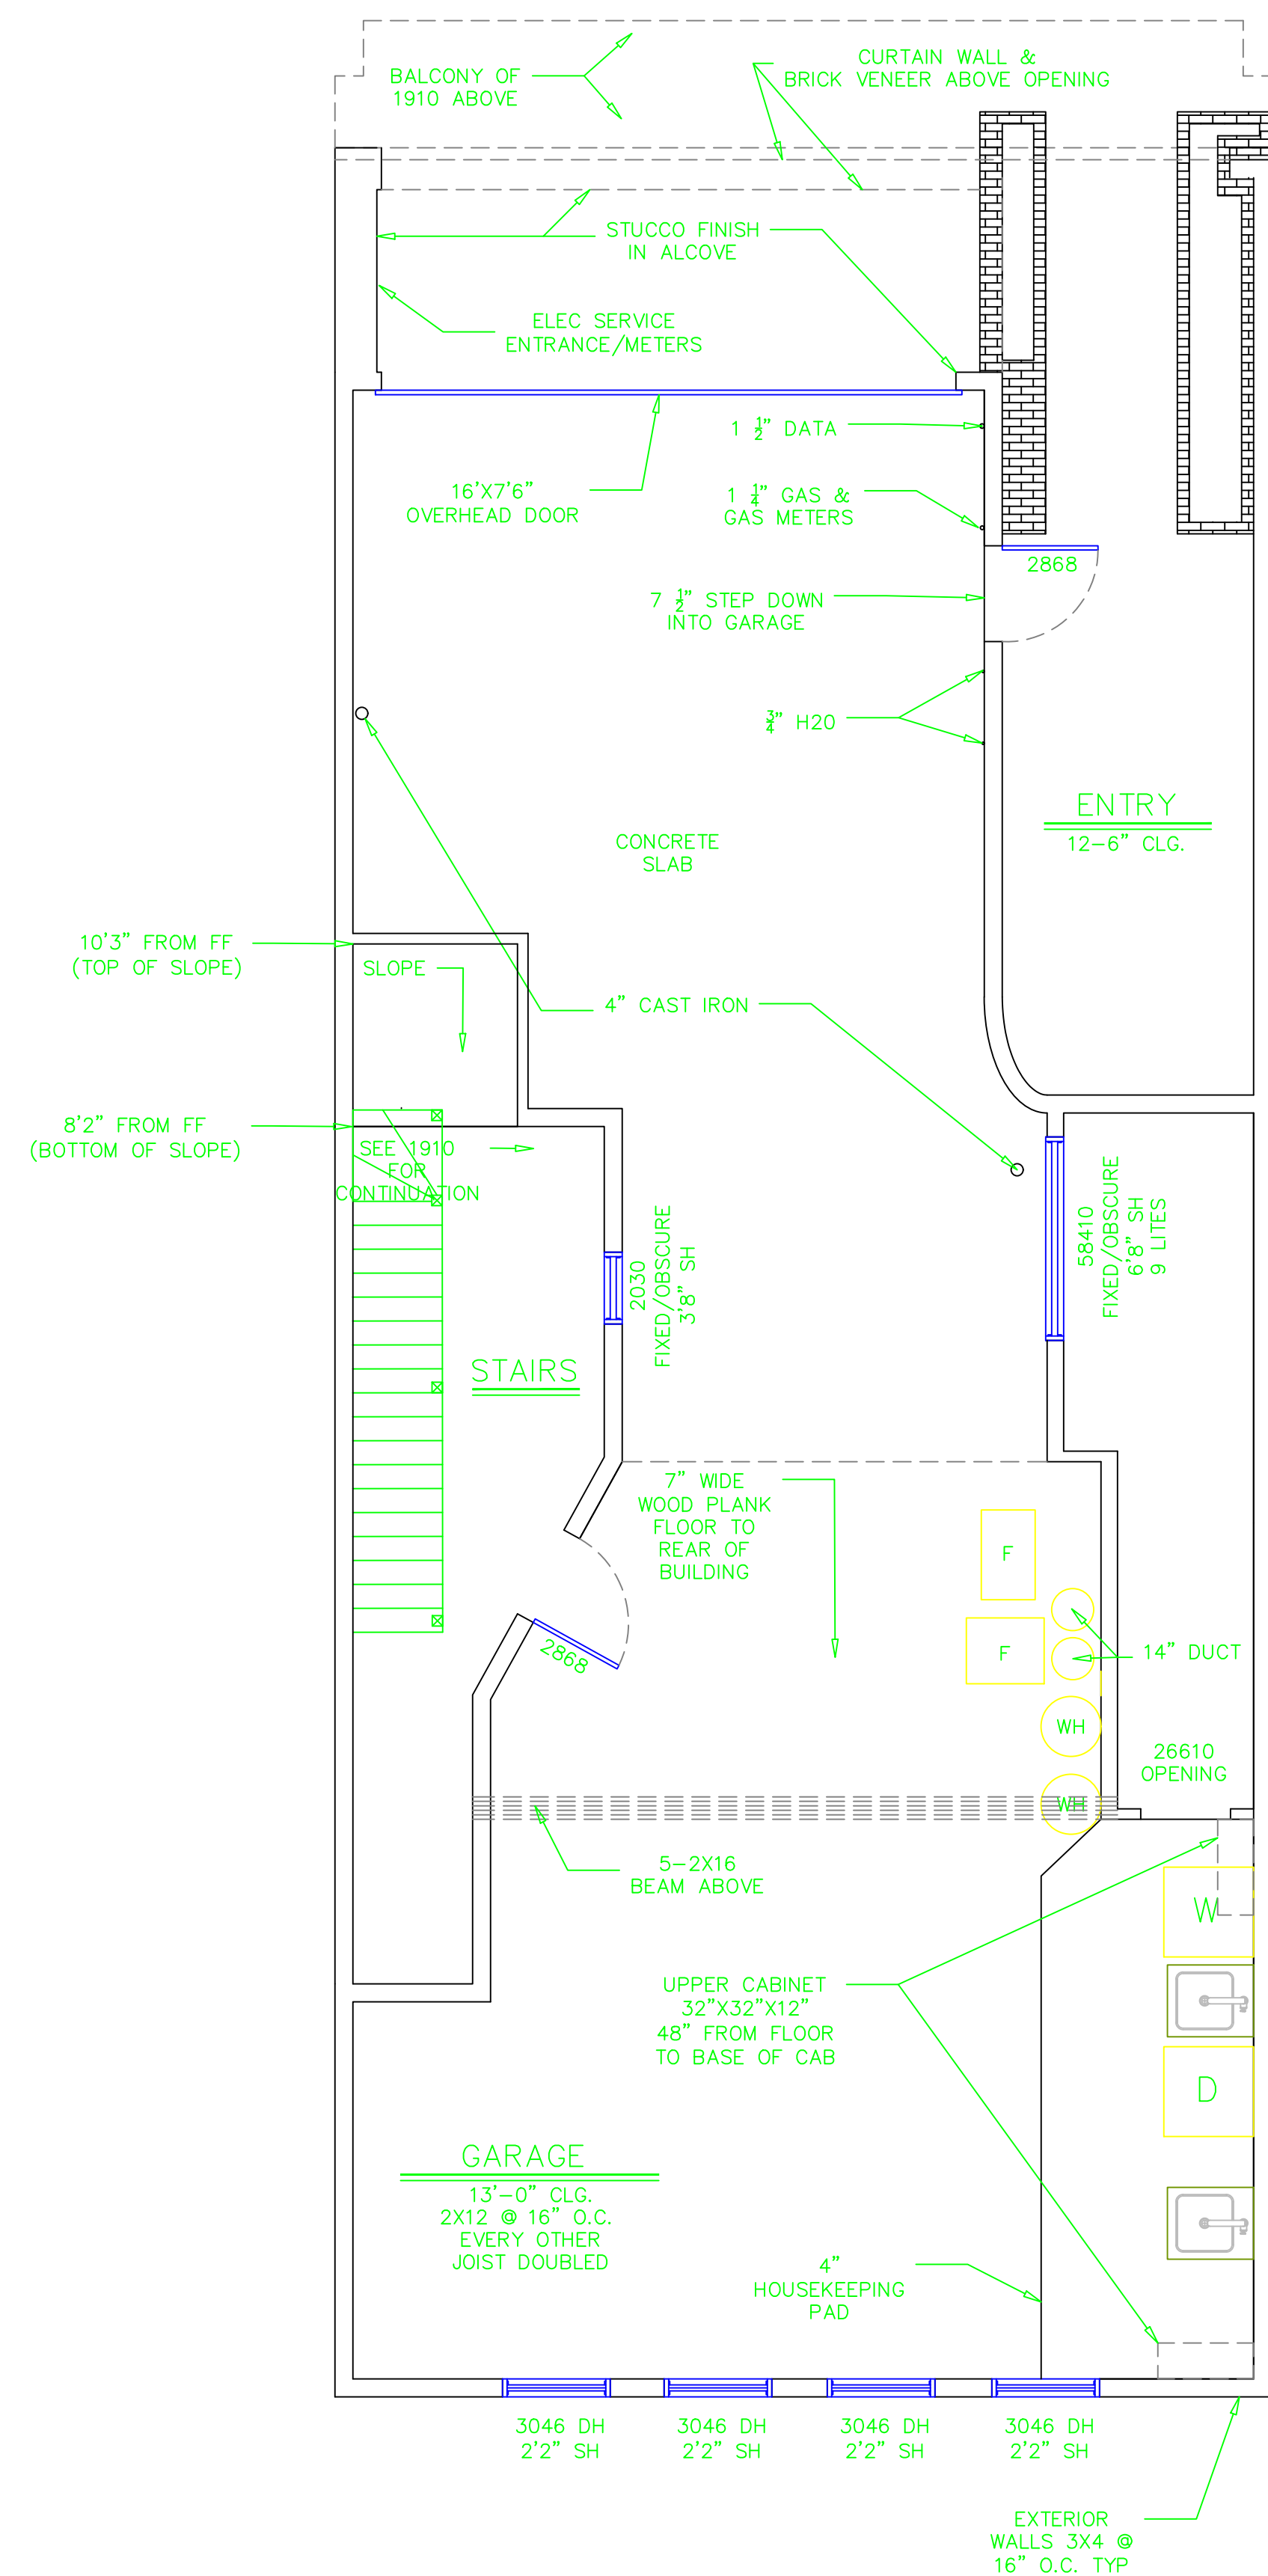

GARAGE
 SCALE: 1/4"=1'-0"

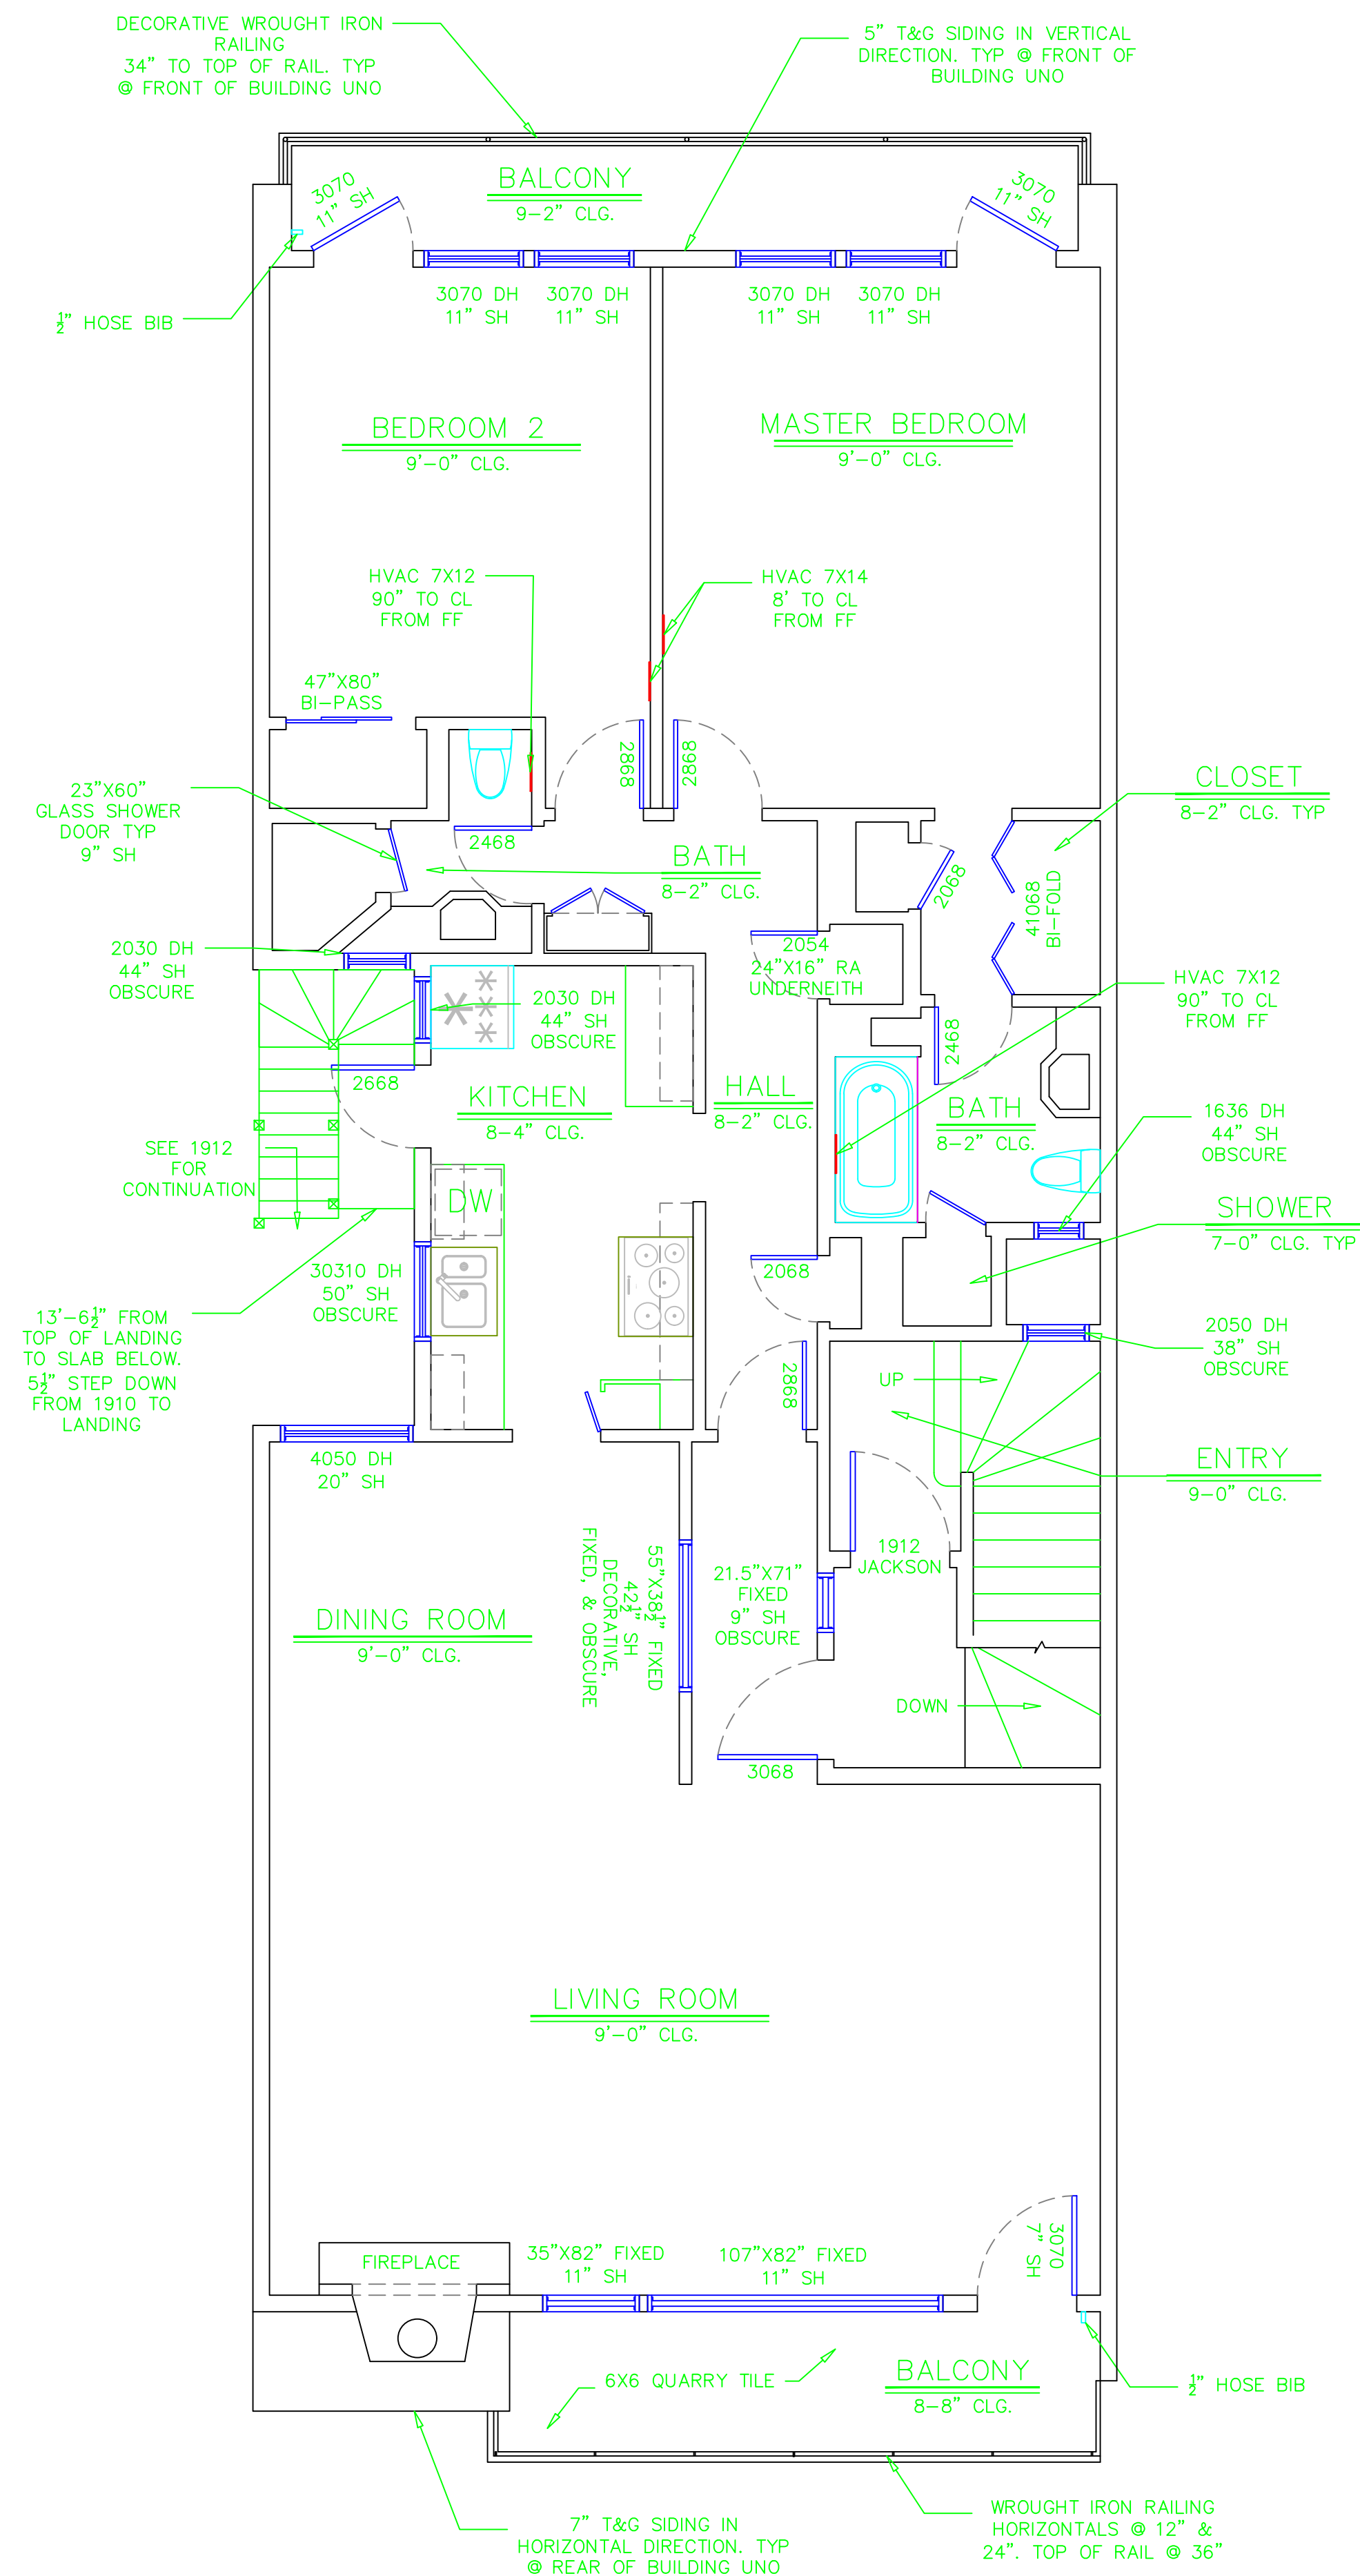

1910 JACKSON ST
SCALE: 1/4"=1'-0"

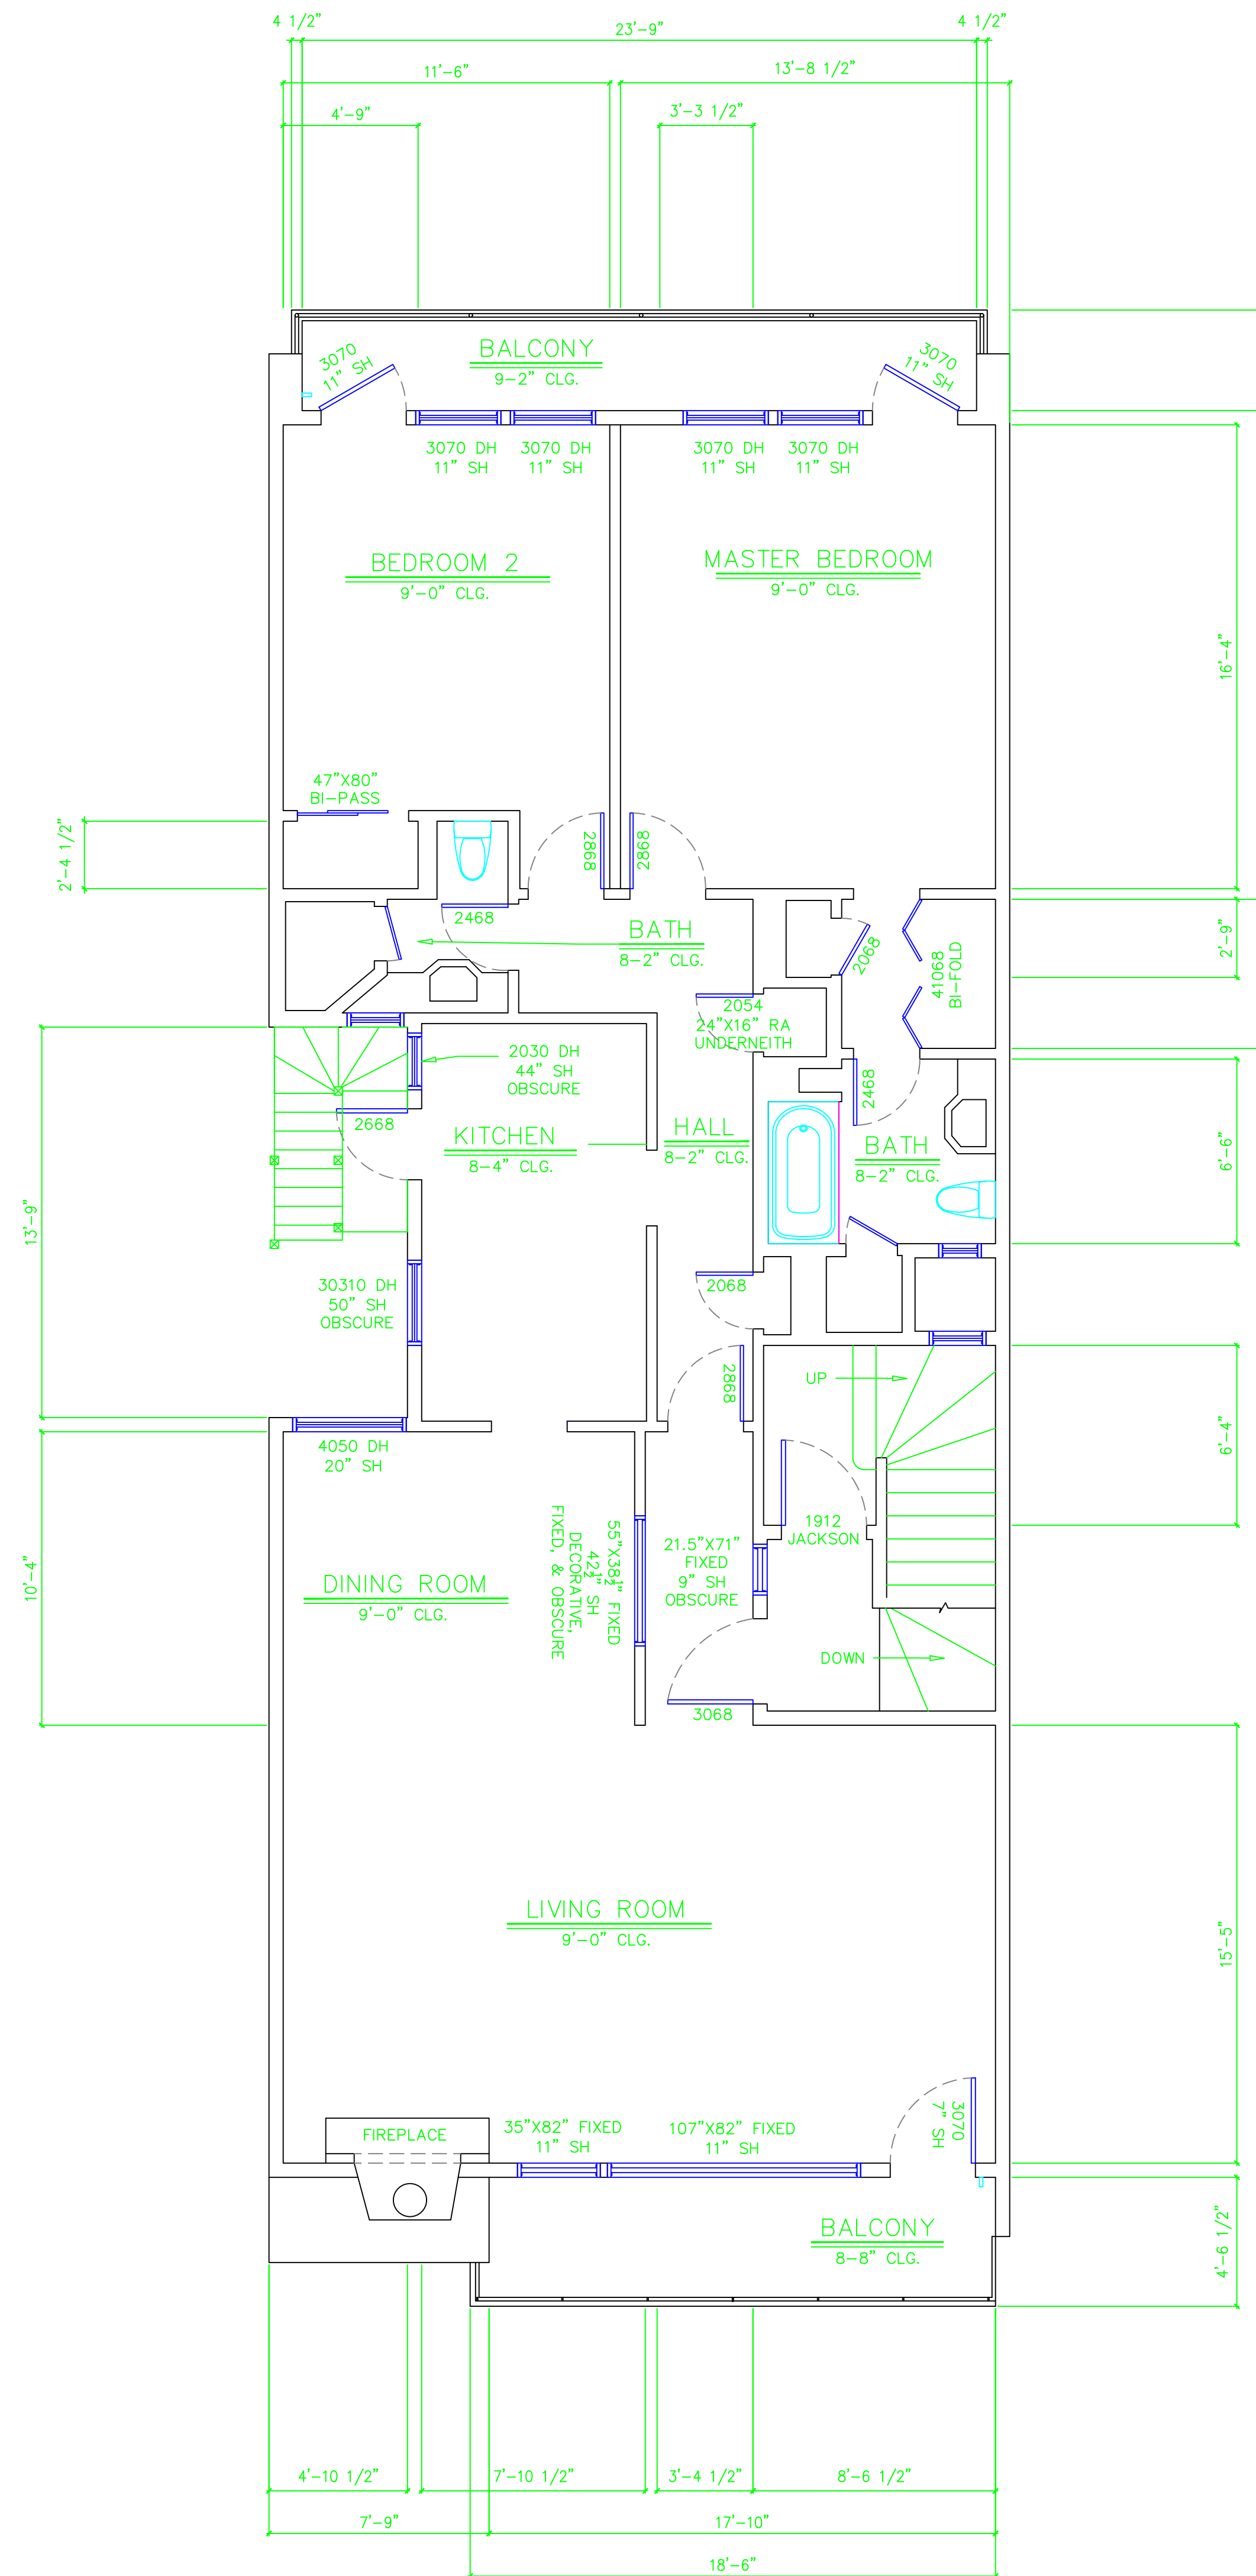

Revision History

	AS-BUILT
	PRELIMINARY DESIGN
	DESIGN
	PERMIT SET
1	PLAN REVIEW COMMENTS
2	PLAN REVIEW COMMENTS

REMODEL & ADDITION

OWNER:

Drawing By:

Chris Klimen

klimen@att.net

PH: 510.928.1359

Peter Christopher Klimen
DIGITALLY SIGNED BY PETER CHRISTOPHER KLIMEN
EMAIL: KLIMEN@ATT.NET DATE: 000000

AS-BUILT
LEVEL 3
1910 JACKSON

AB3

Revision History

	AS-BUILT
	PRELIMINARY DESIGN
	DESIGN
	PERMIT SET
①	PLAN REVIEW COMMENTS
②	PLAN REVIEW COMMENTS

REMODEL & ADDITION

OWNER:

Drawing By:

Chris Klimen



klimen@att.net

PH: 510.928.1359



Peter Christopher Klimen
DIGITALLY SIGNED BY PETER CHRISTOPHER KLIMEN
 EMAIL: KLIMEN@ATT.NET DATE: 000000

AS-BUILT
 LEVEL 4
 1912 JACKSON
 1ST FLOOR

AB4

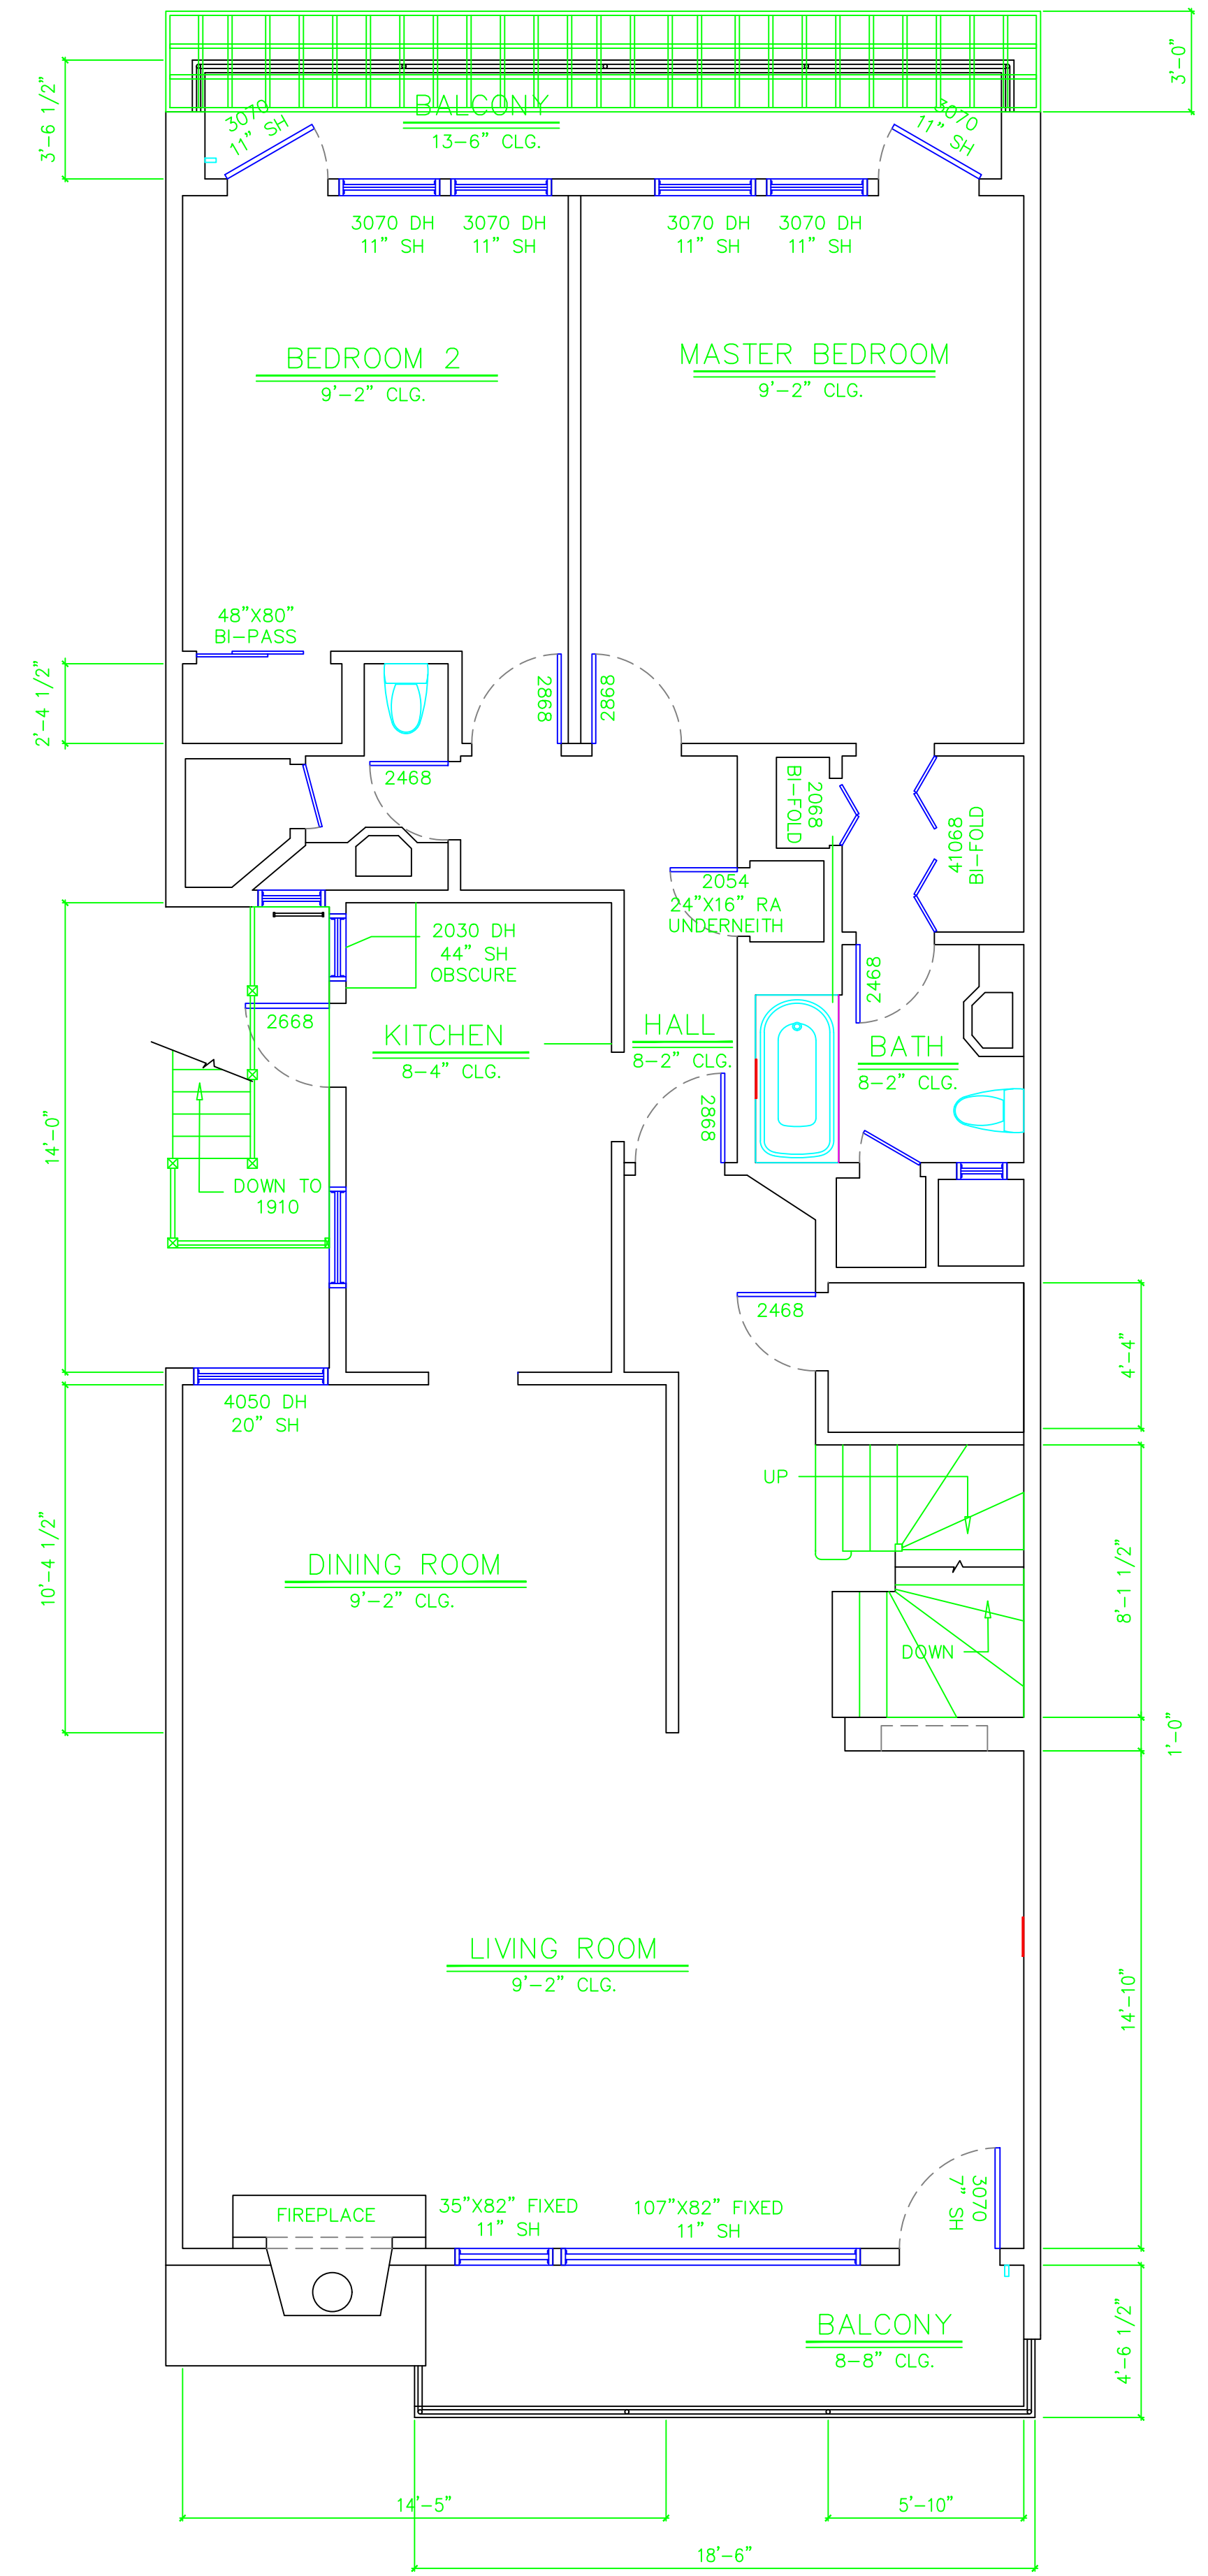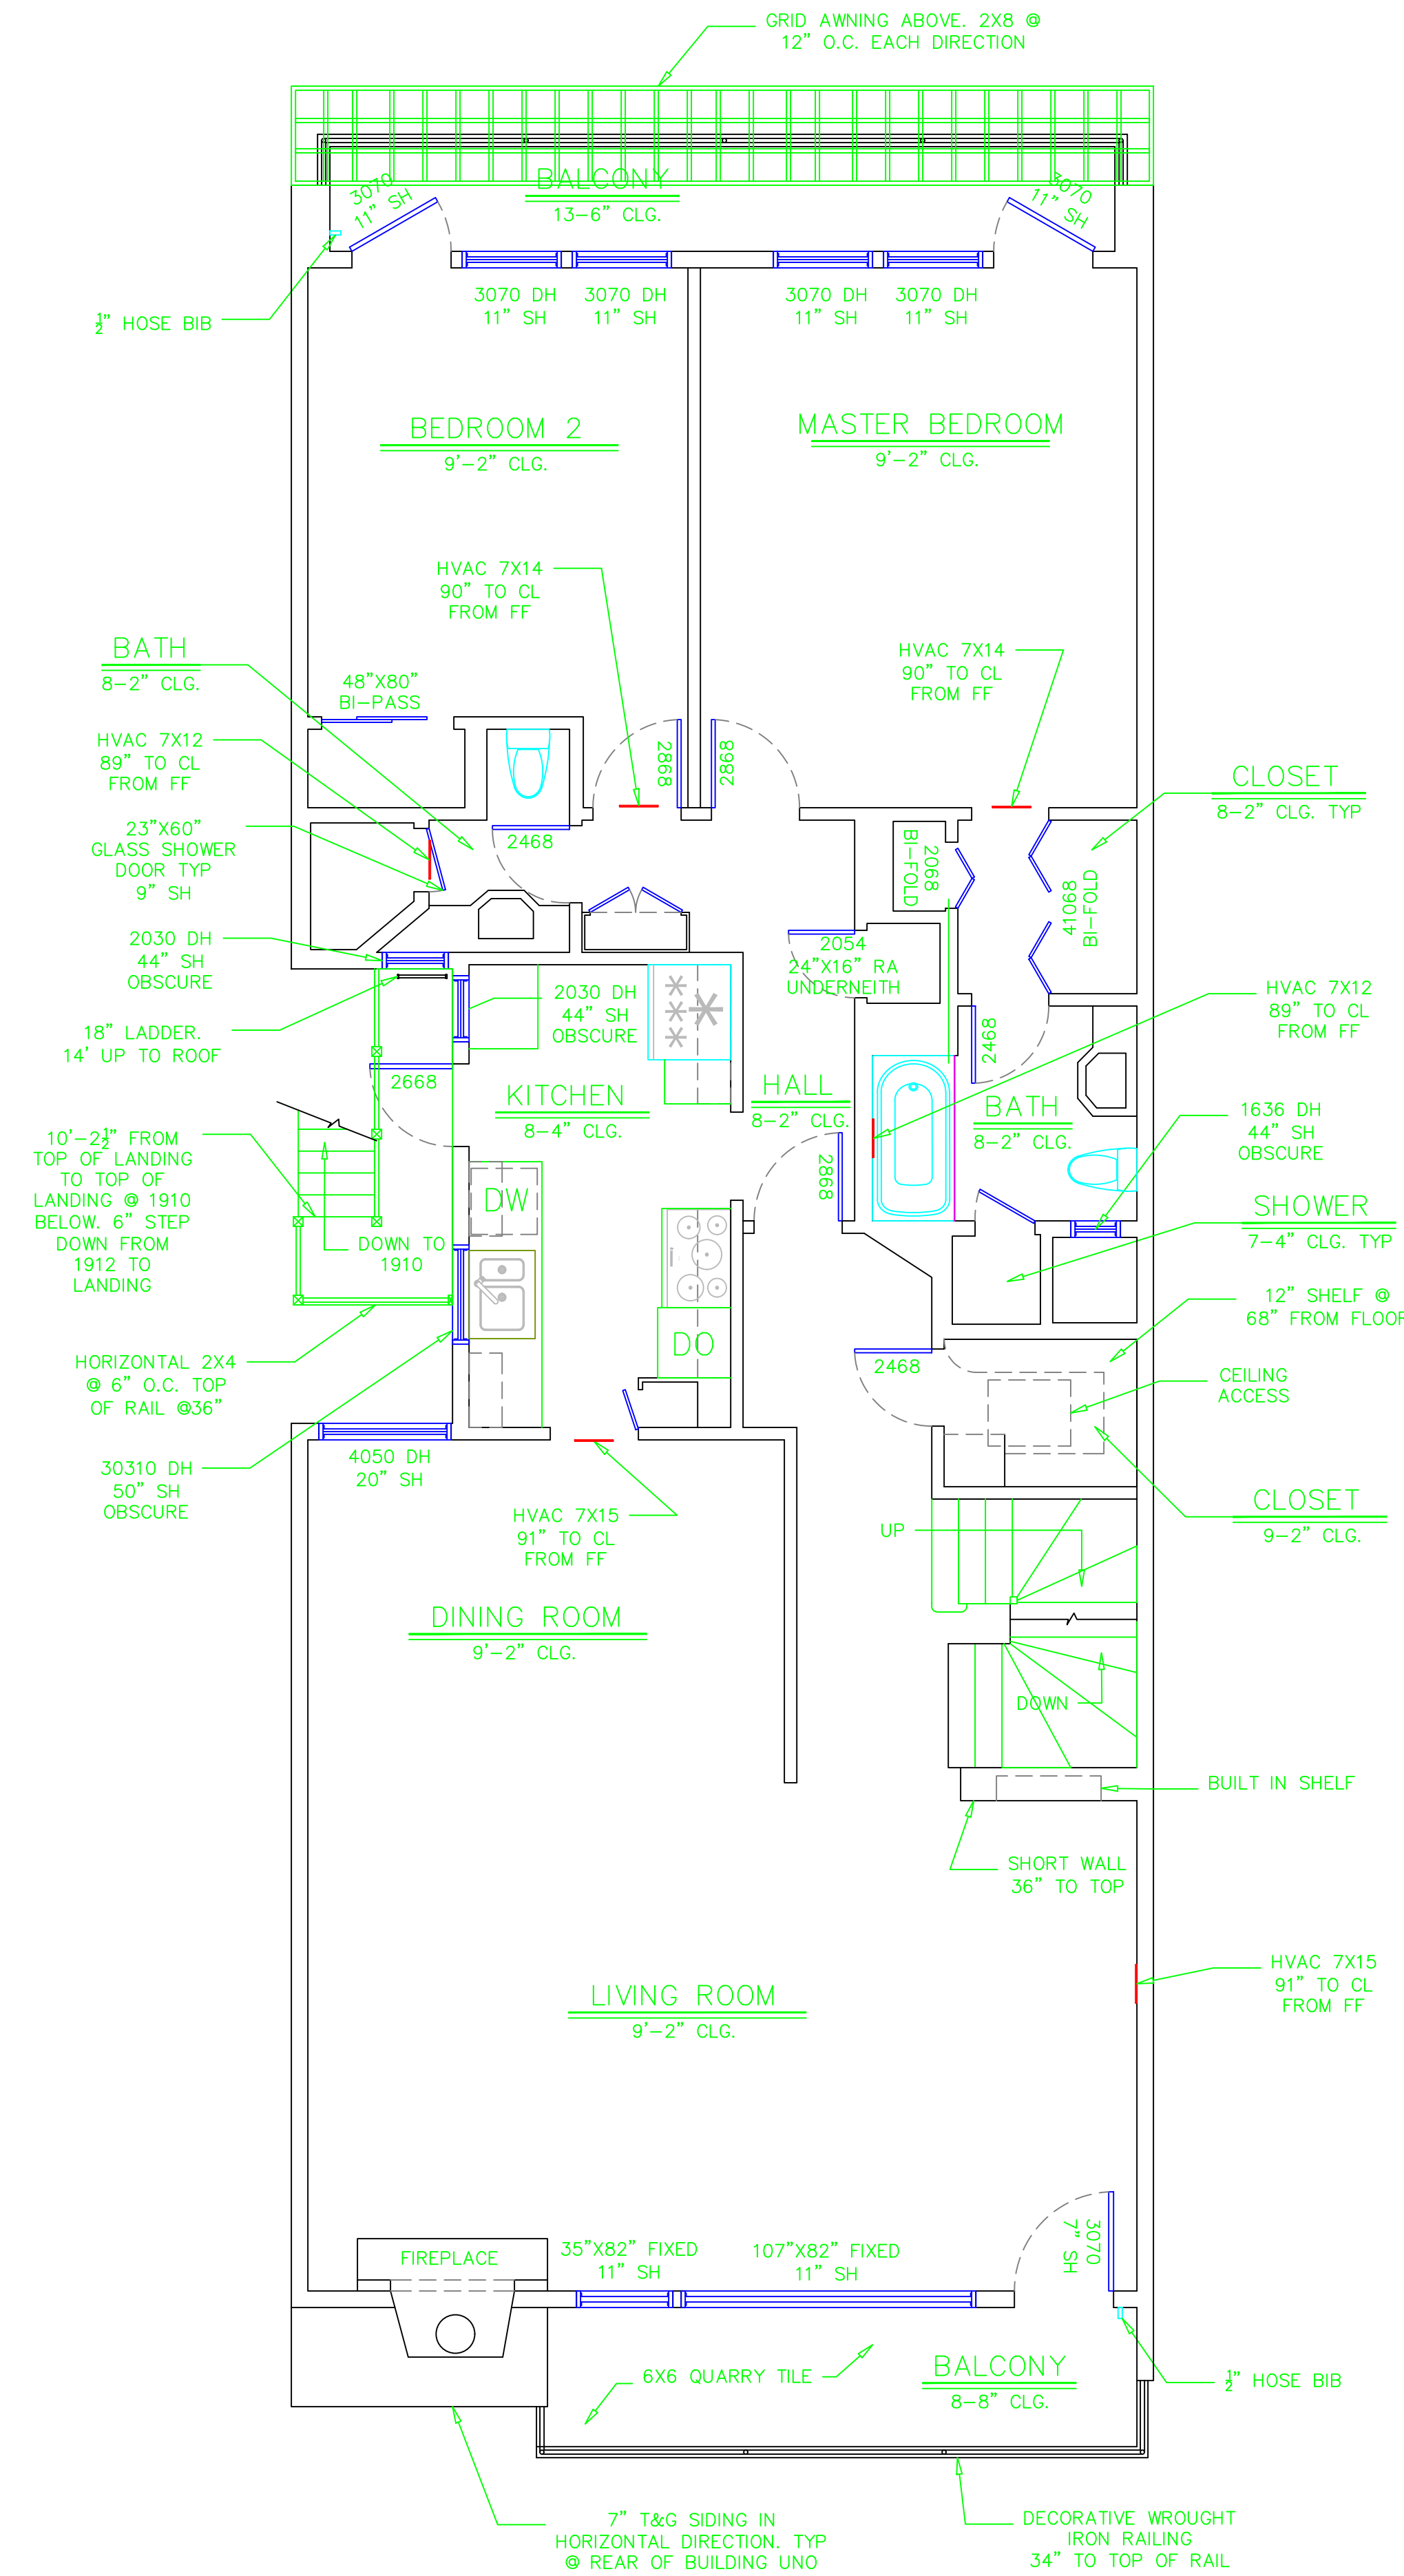

1912 JACKSON ST – 1ST FLOOR
 SCALE: 1/4"=1'-0"

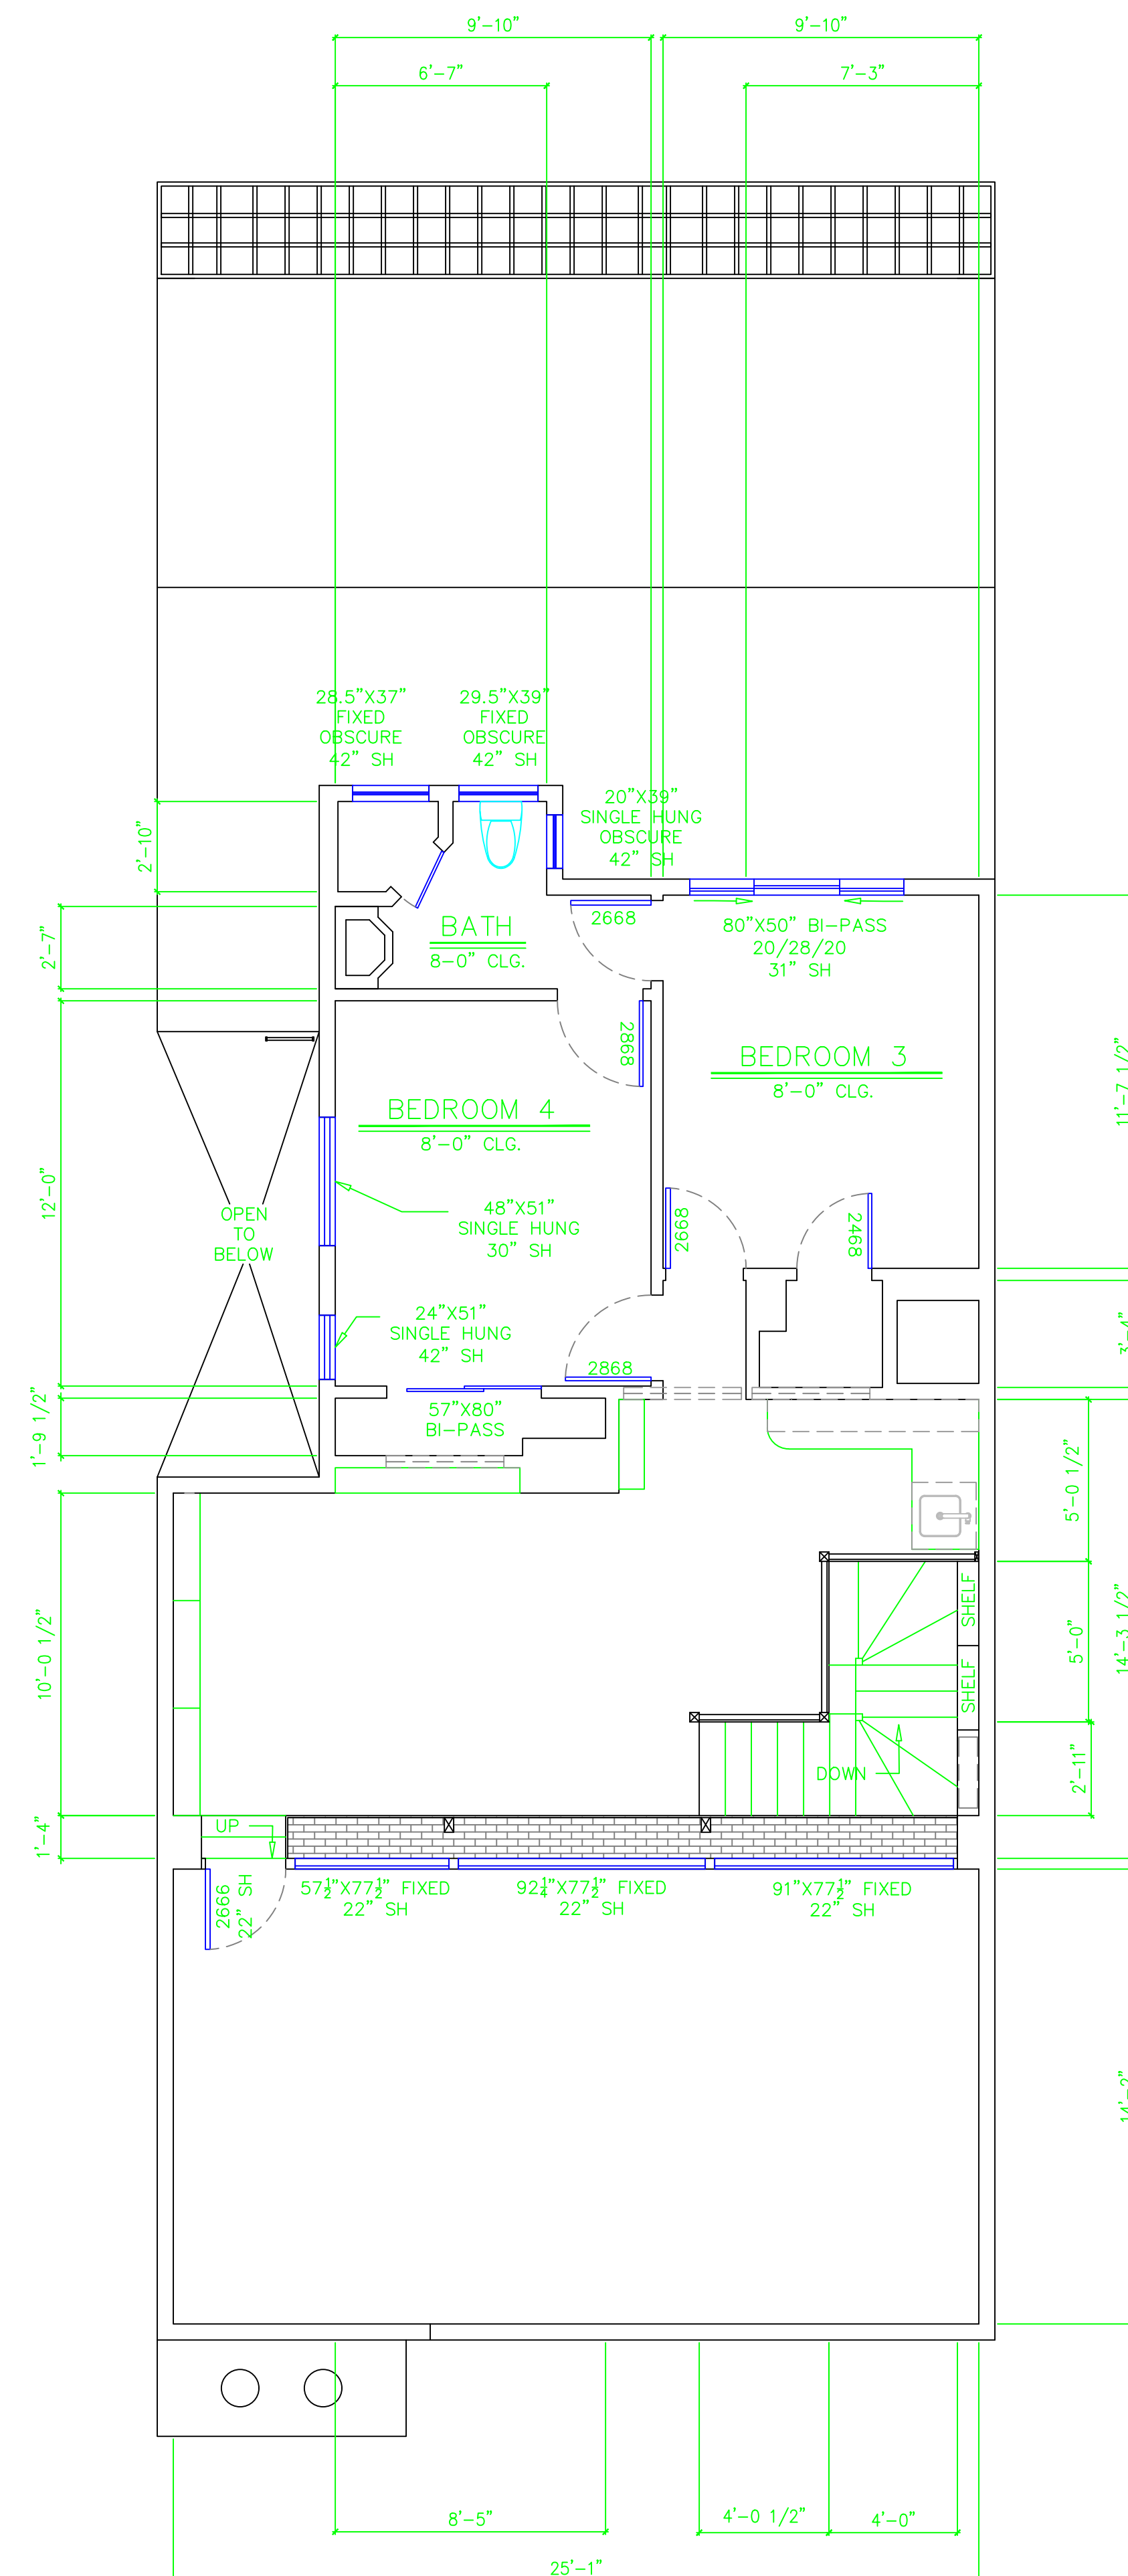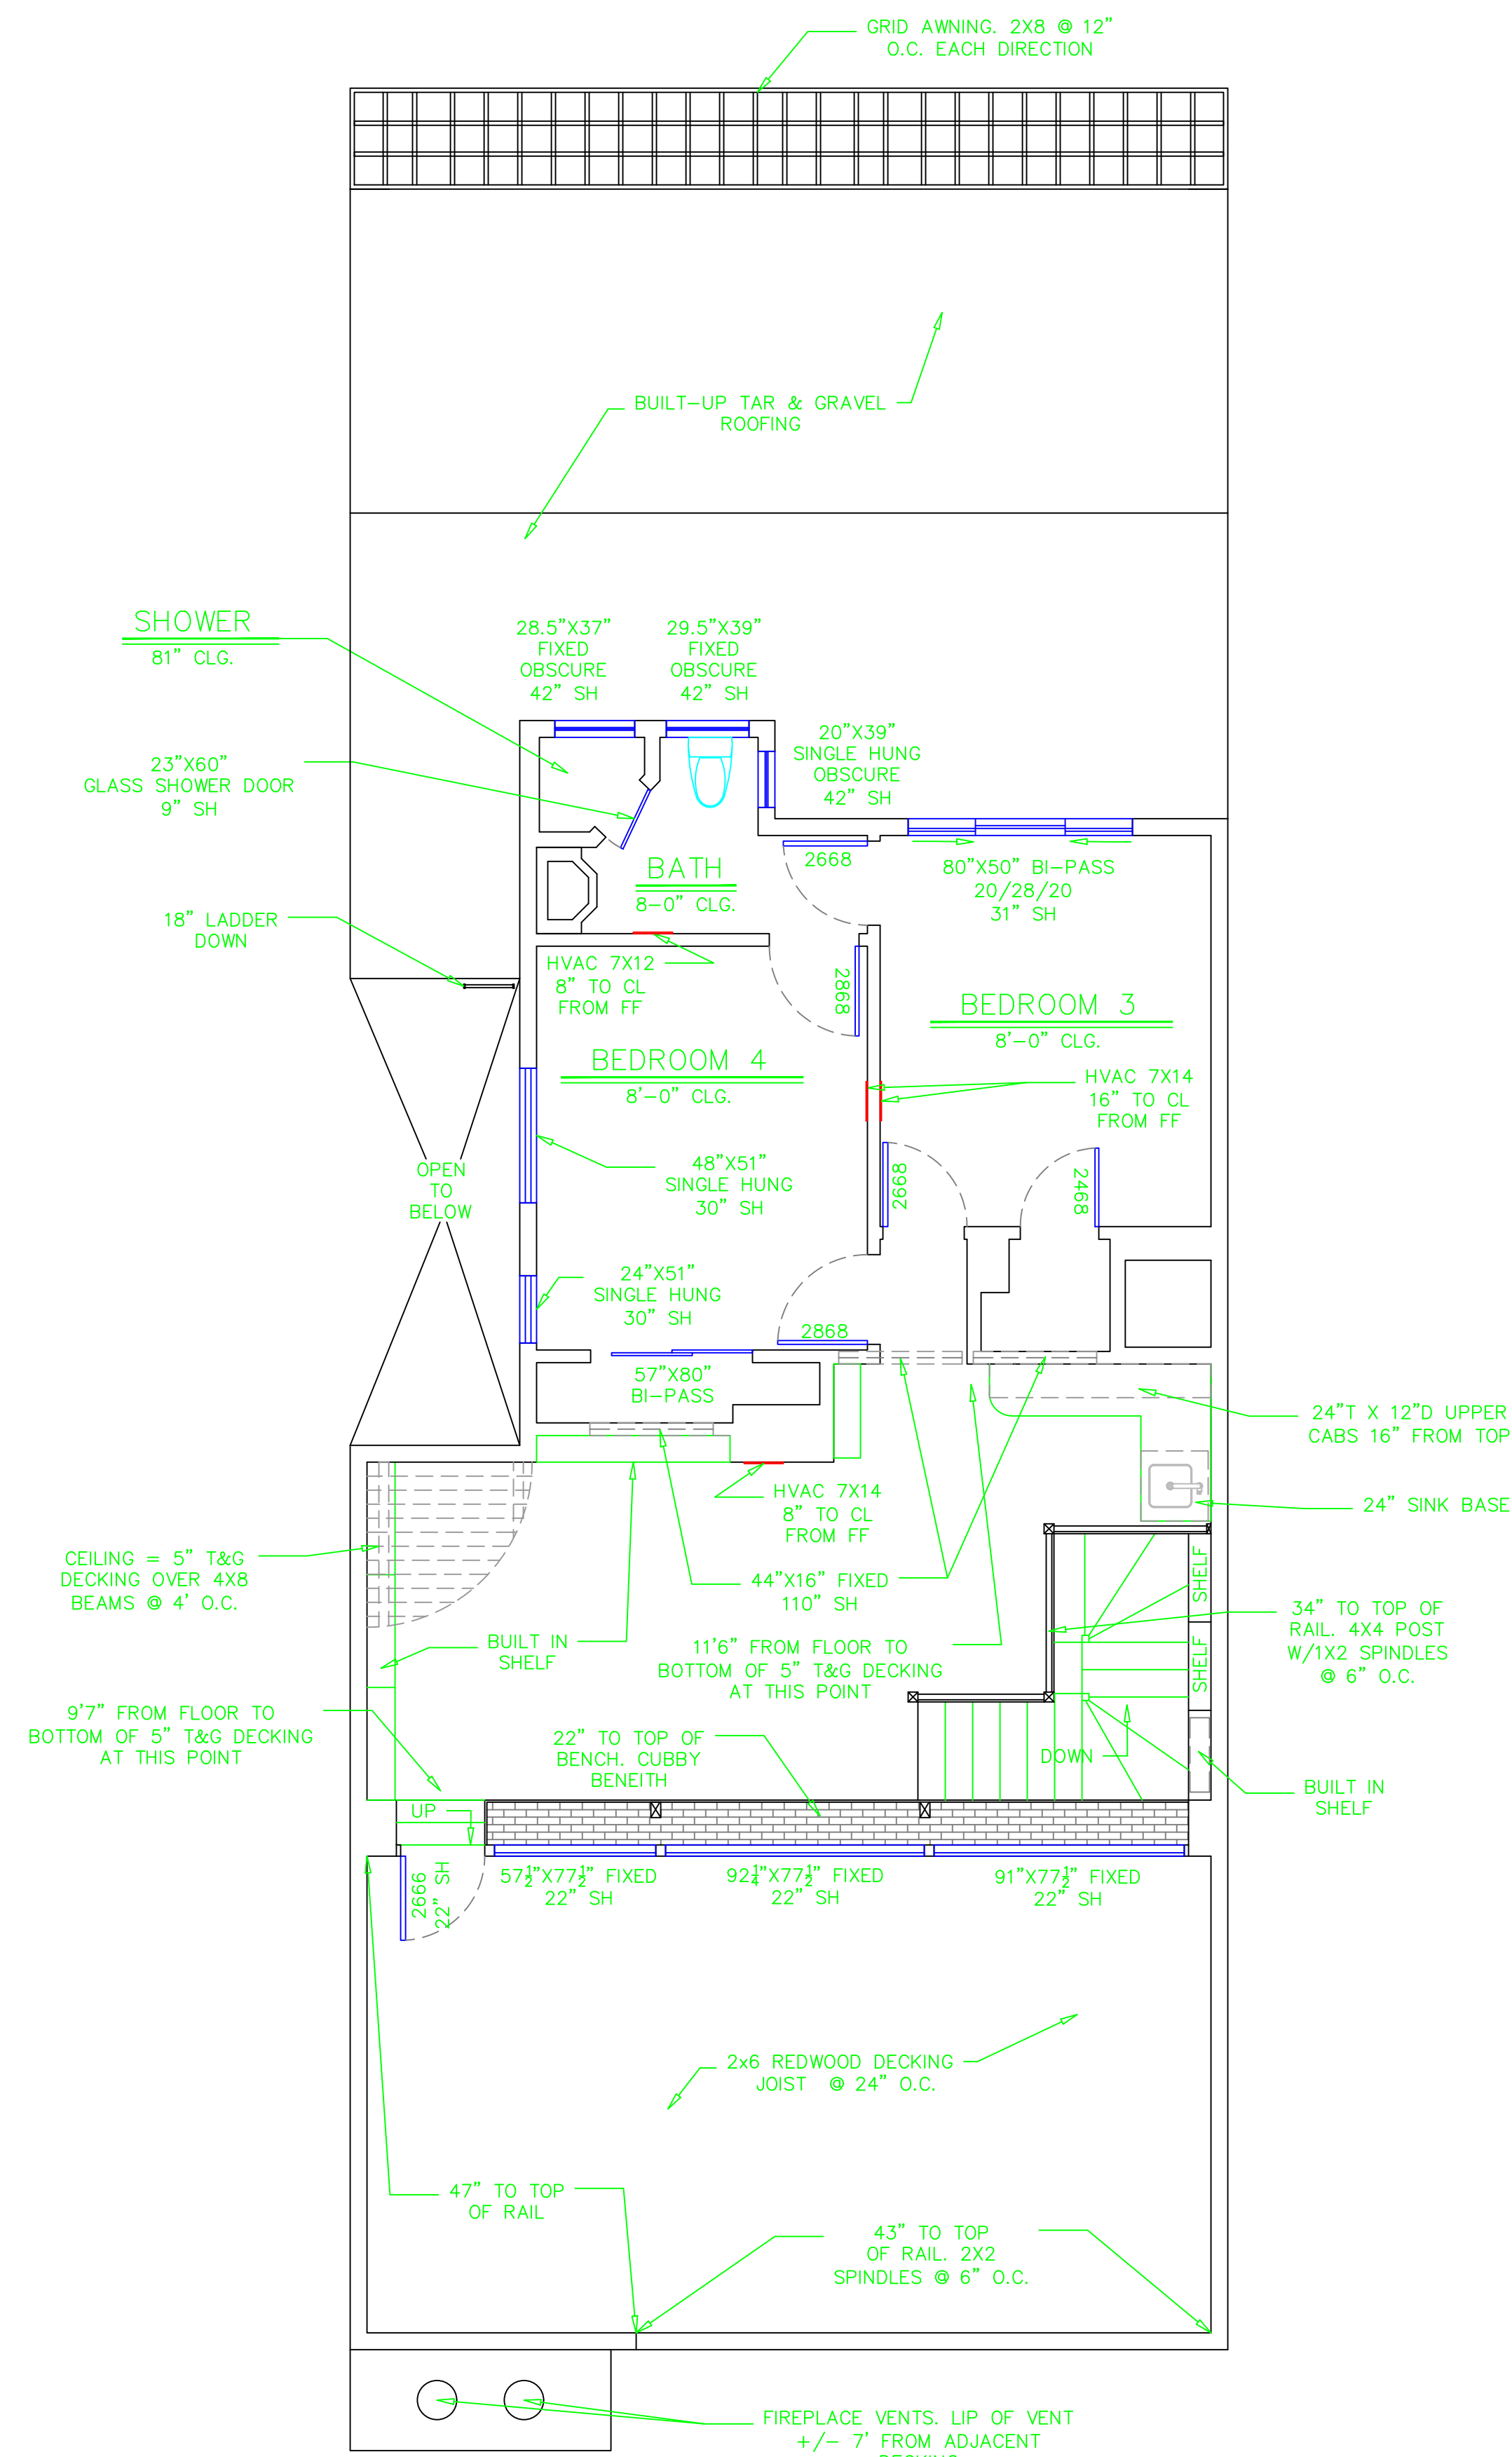

Revision History	
	AS-BUILT
	PRELIMINARY DESIGN
	DESIGN
	PERMIT SET
1	PLAN REVIEW COMMENTS
2	PLAN REVIEW COMMENTS

REMODEL & ADDITION



OWNER:

Drawing By:
Chris Klimen
klimen@att.net
PH: 510.928.1359

Peter Christopher Klimen
DIGITALLY SIGNED BY PETER CHRISTOPHER KLIMEN
EMAIL: KLIMEN@ATT.NET DATE: 000000

AS-BUILT
LEVEL 5
1912 JACKSON
2ND FLOOR

AB5

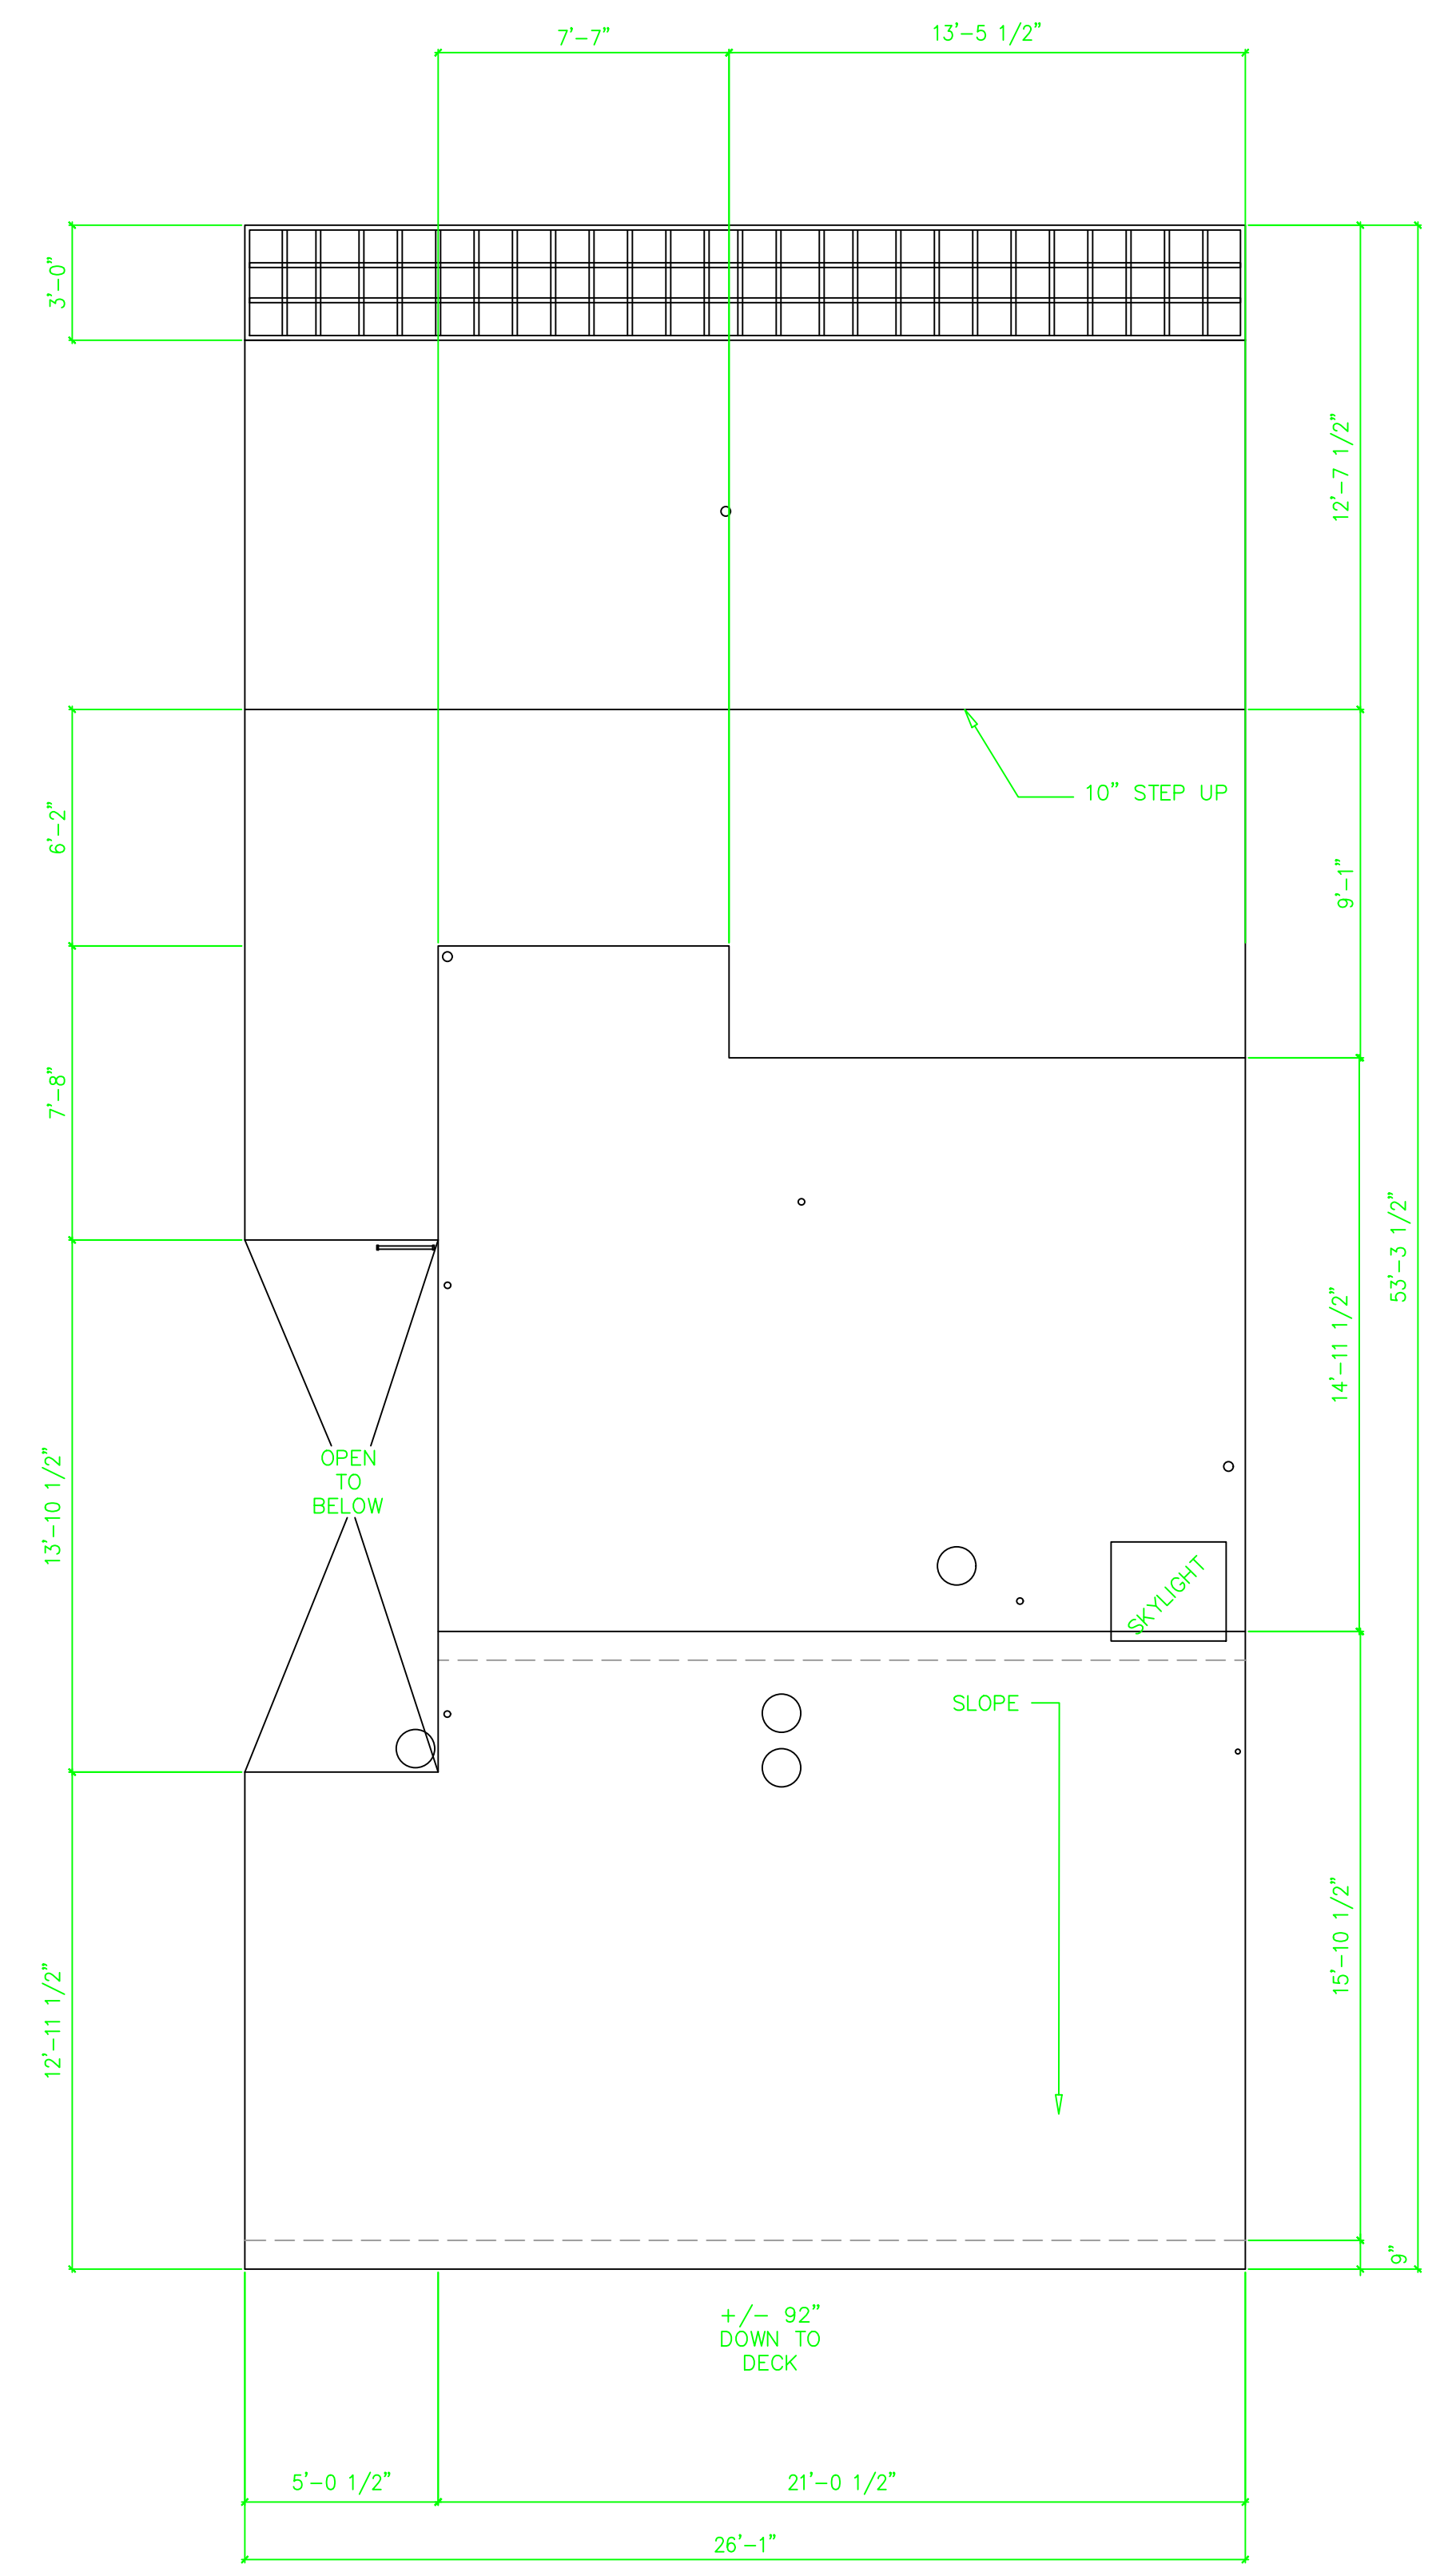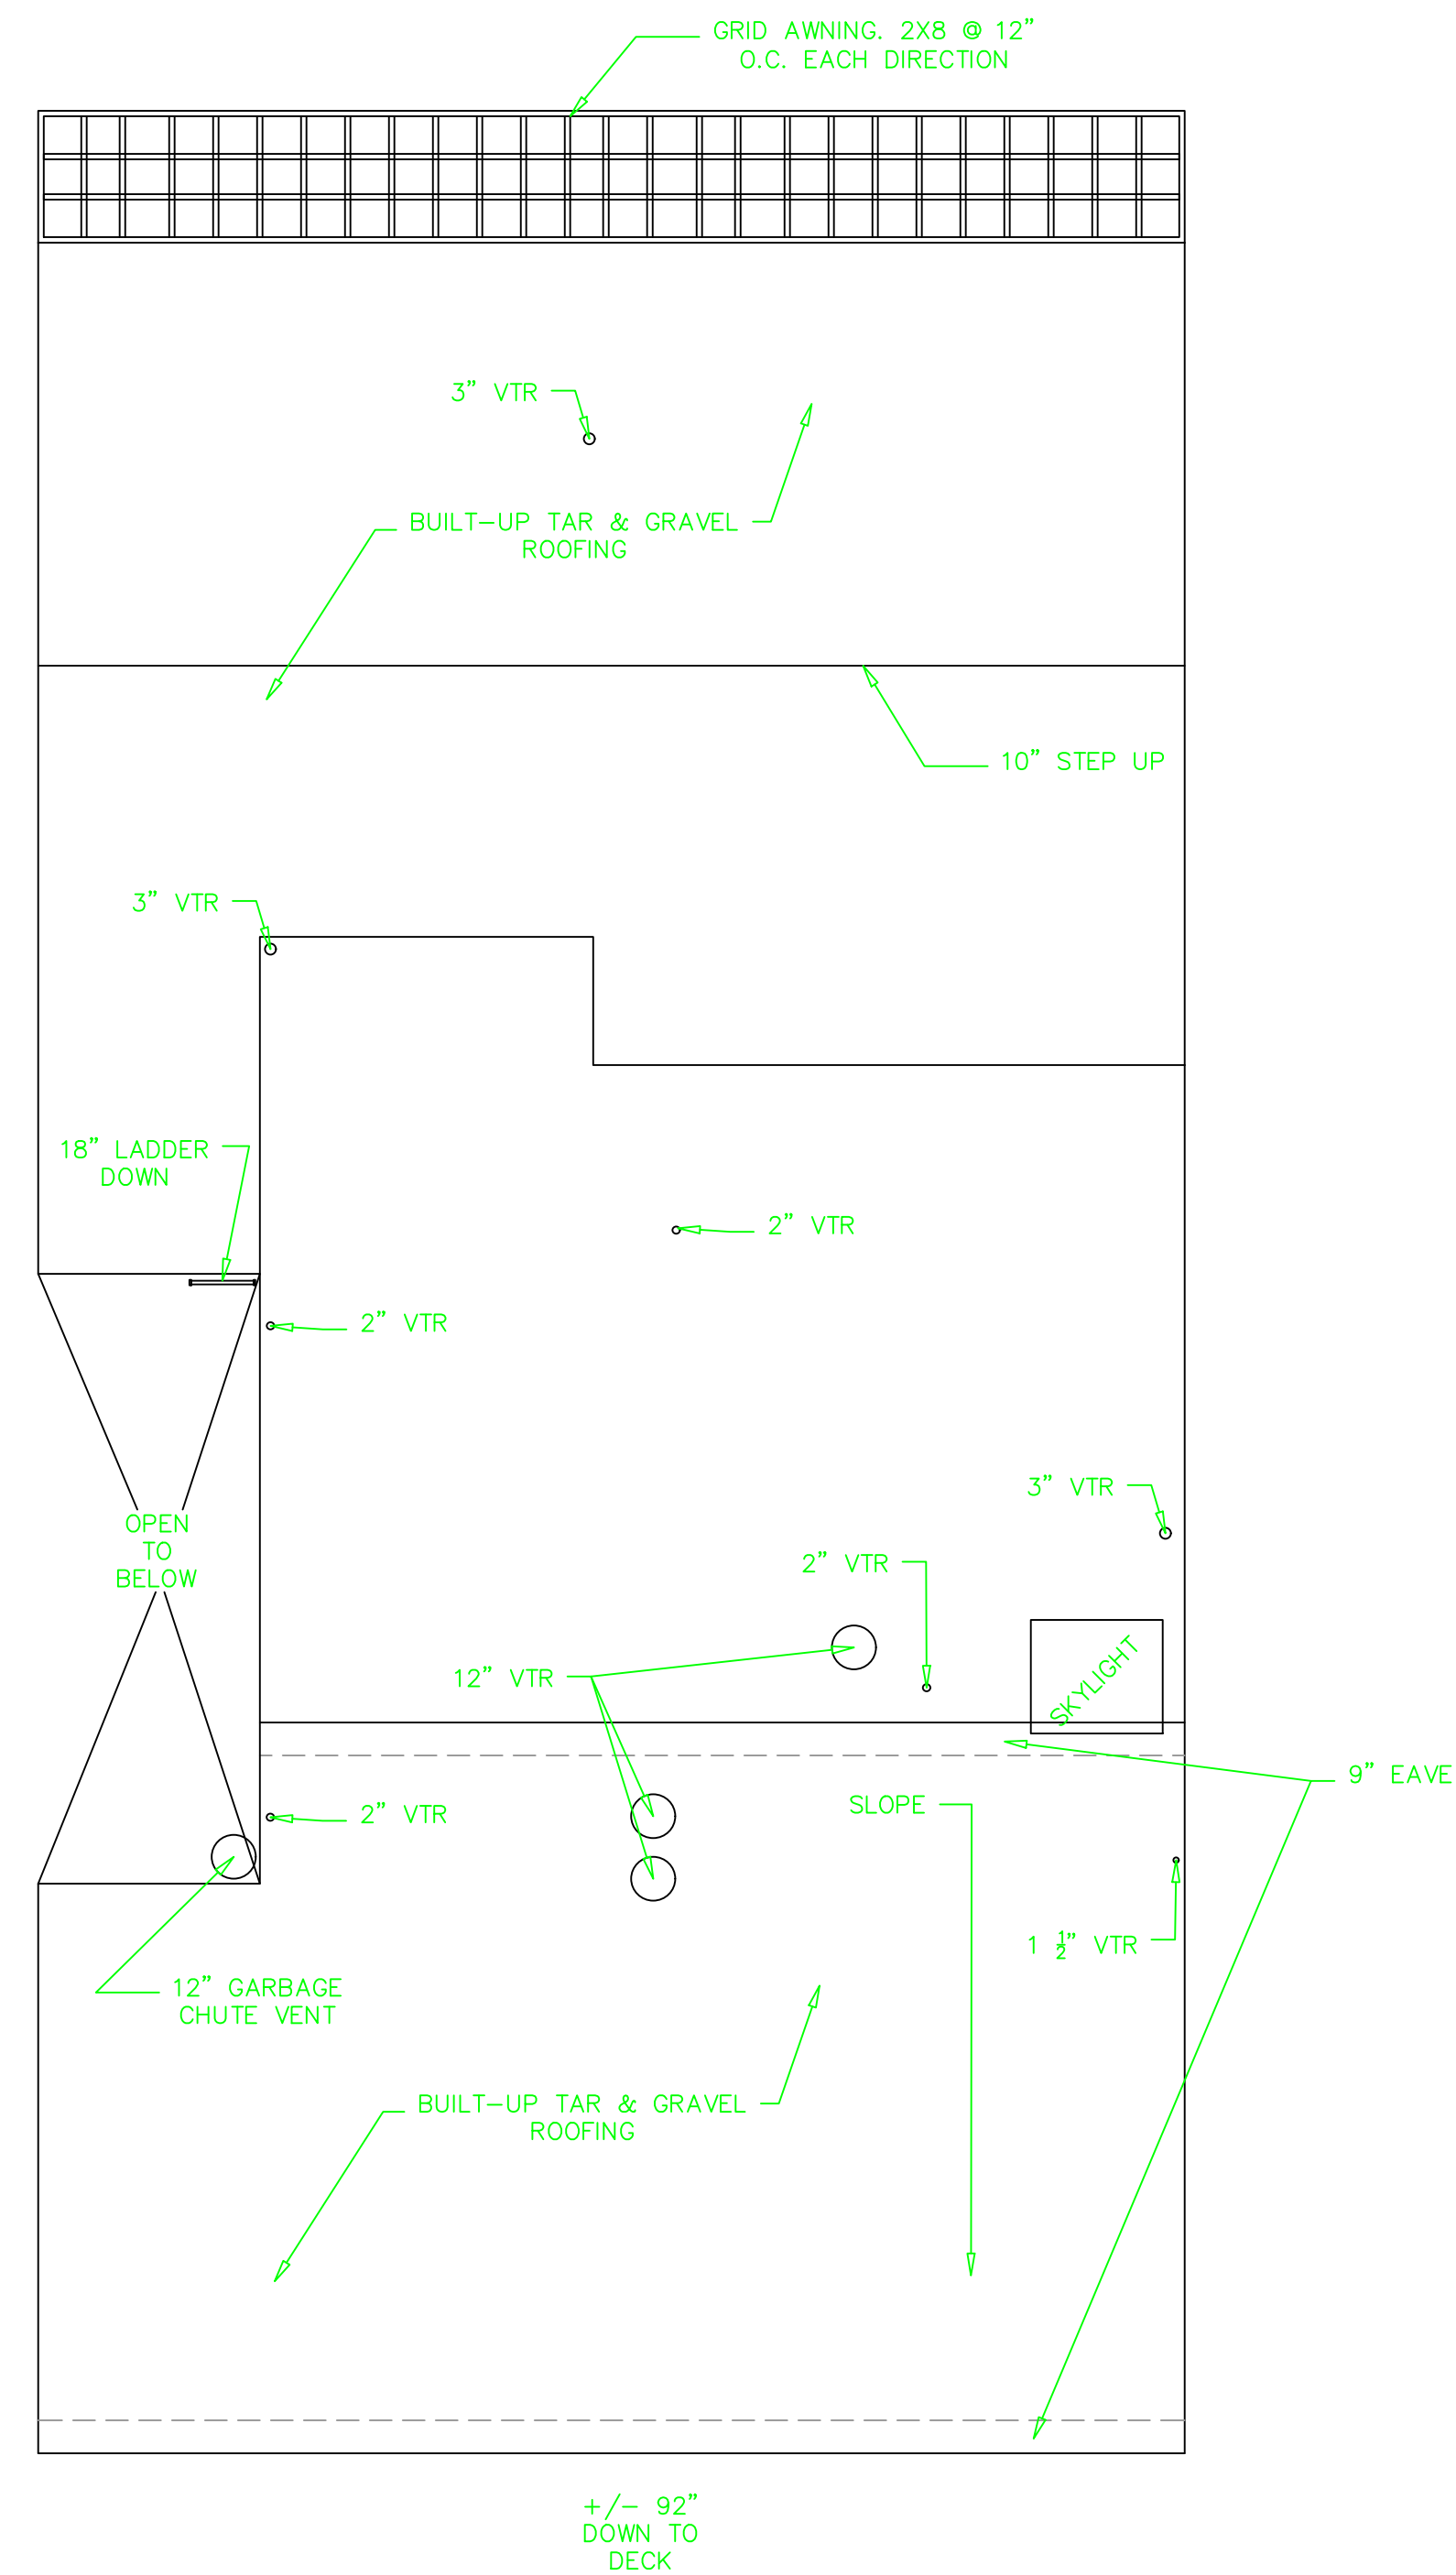

Revision History

	AS-BUILT
	PRELIMINARY DESIGN
	DESIGN
	PERMIT SET
1	PLAN REVIEW COMMENTS
2	PLAN REVIEW COMMENTS

REMODEL & ADDITION

OWNER:

Drawing By:

Chris Klimen

klimen@att.net


PH: 510.928.1359

Peter Christopher Klimen
DIGITALLY SIGNED BY PETER CHRISTOPHER KLIMEN
 EMAIL: KLIMEN@ATT.NET DATE: 000000


AS-BUILT
 ROOF

AB6

ROOF
 SCALE: 1/4"=1'-0"

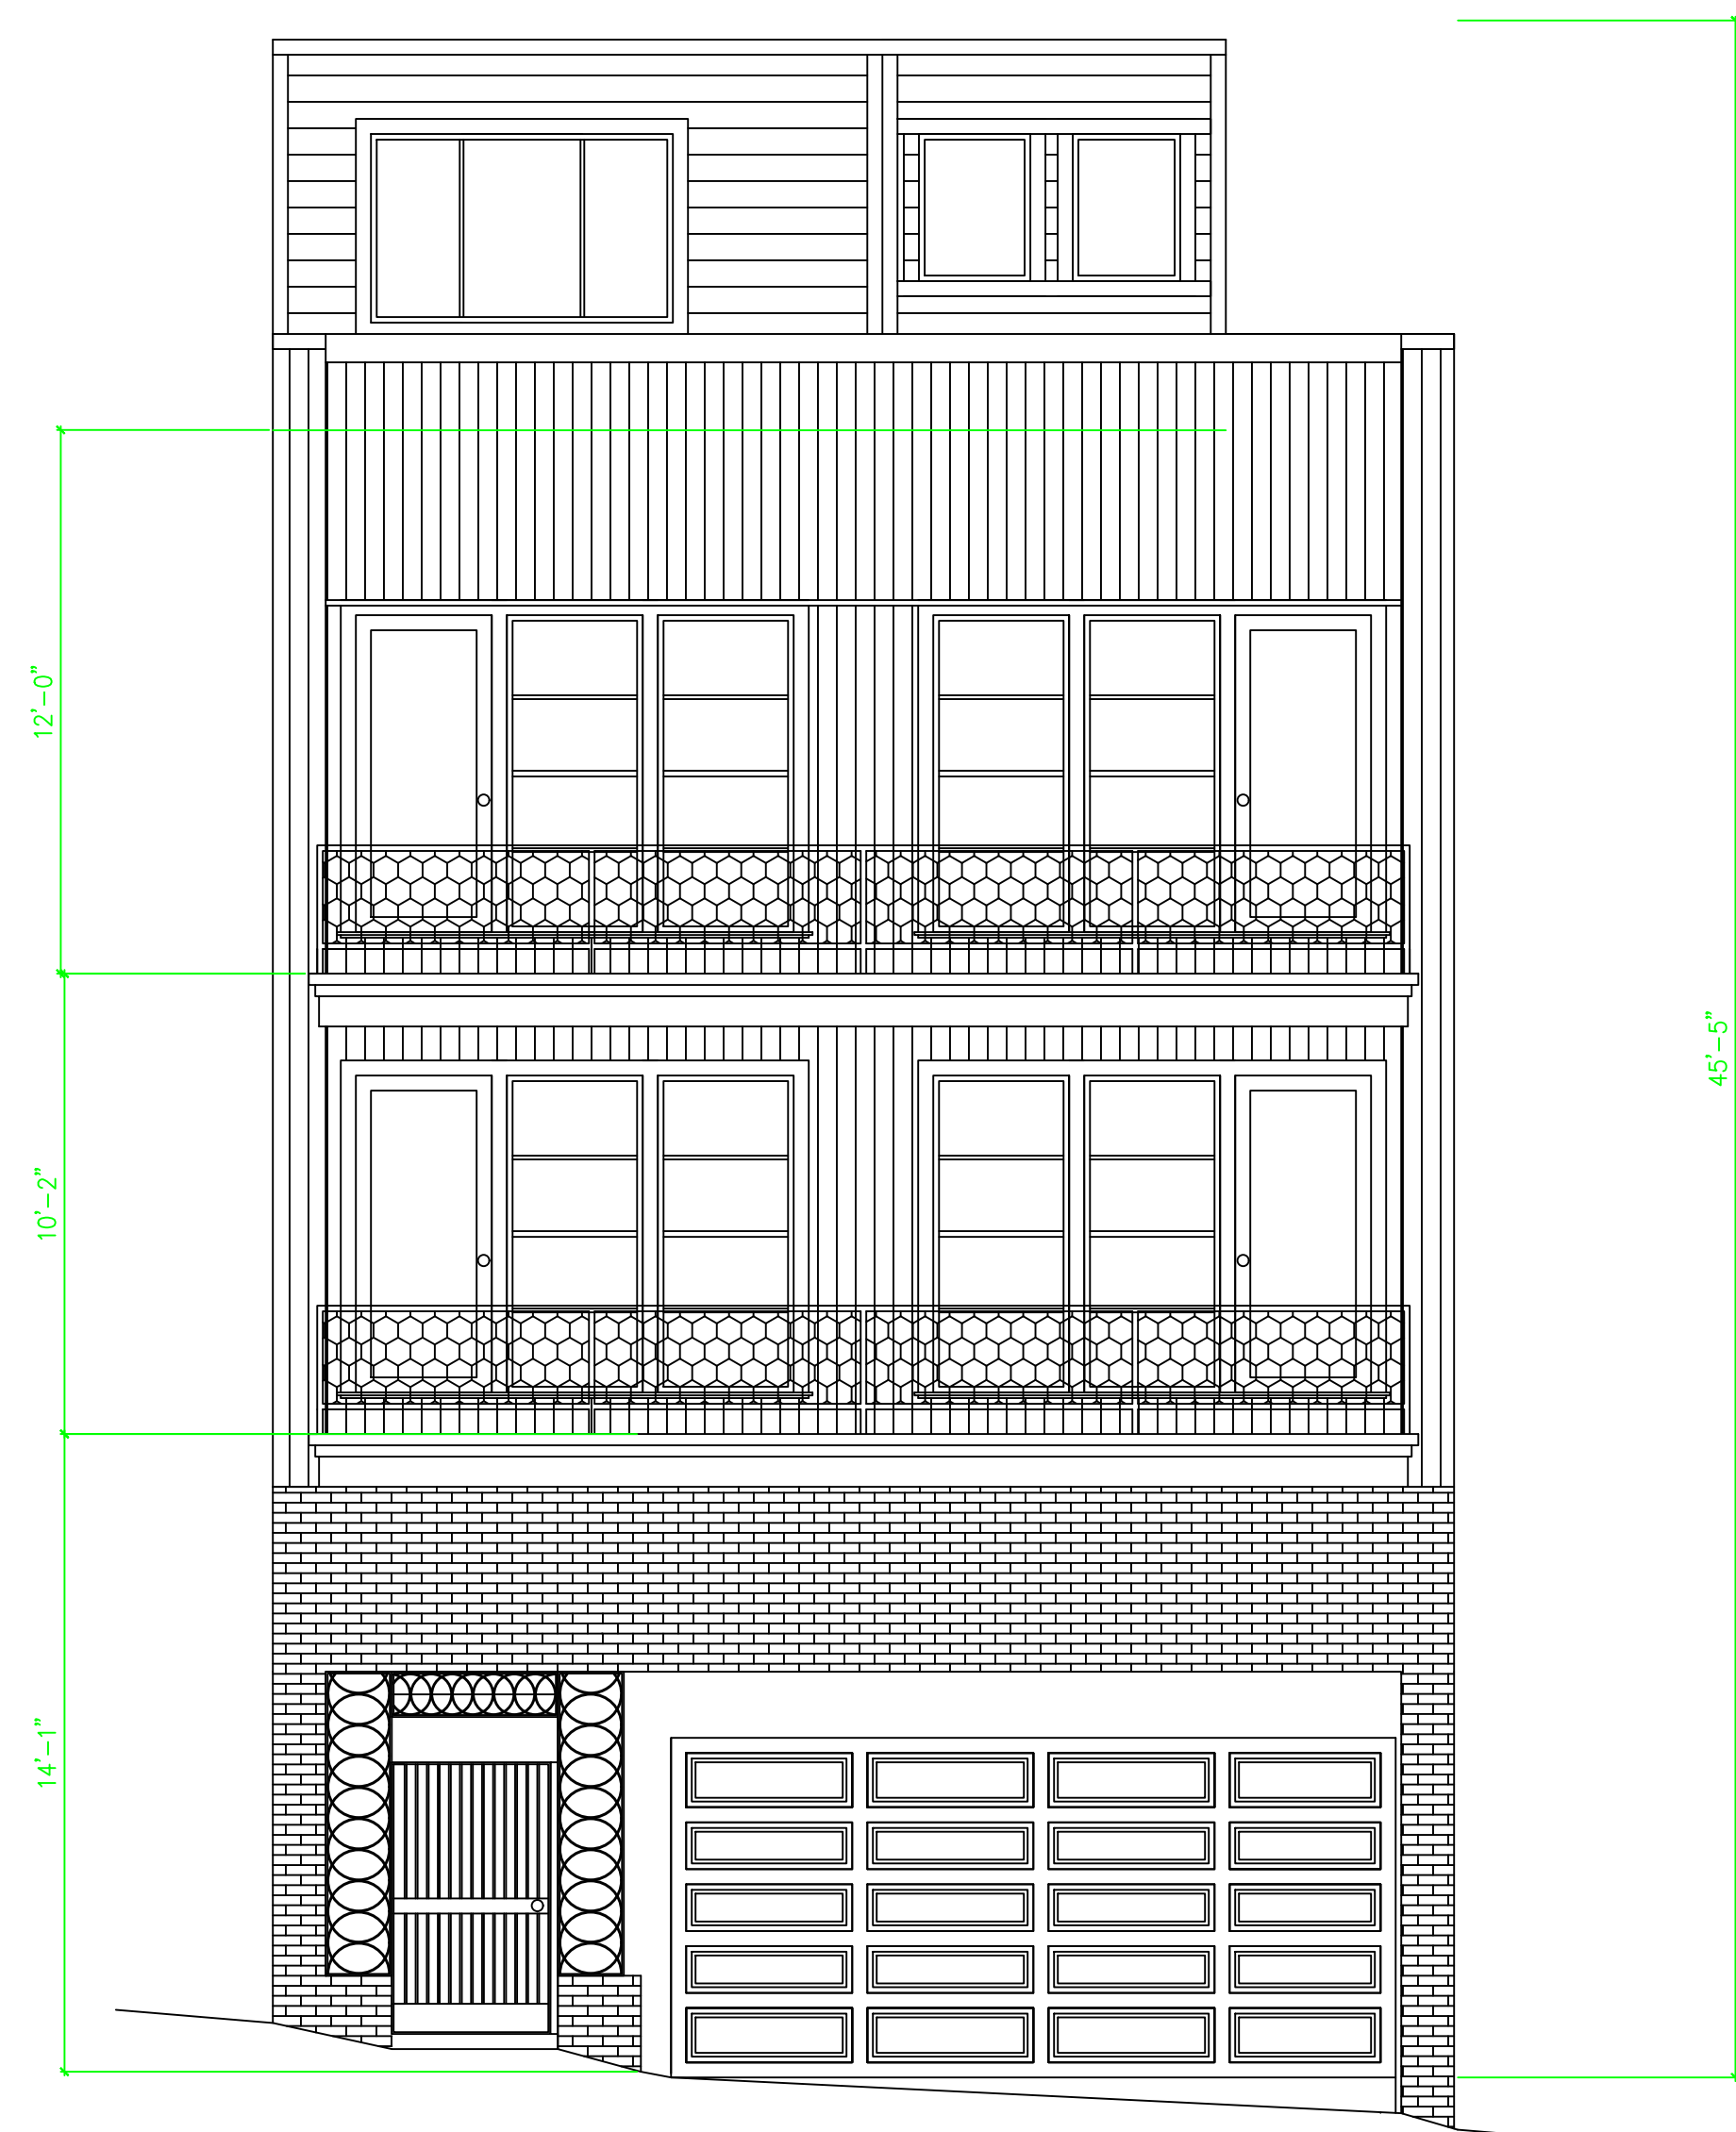

SOUTH ELEVATION – FROM JACKSON ST

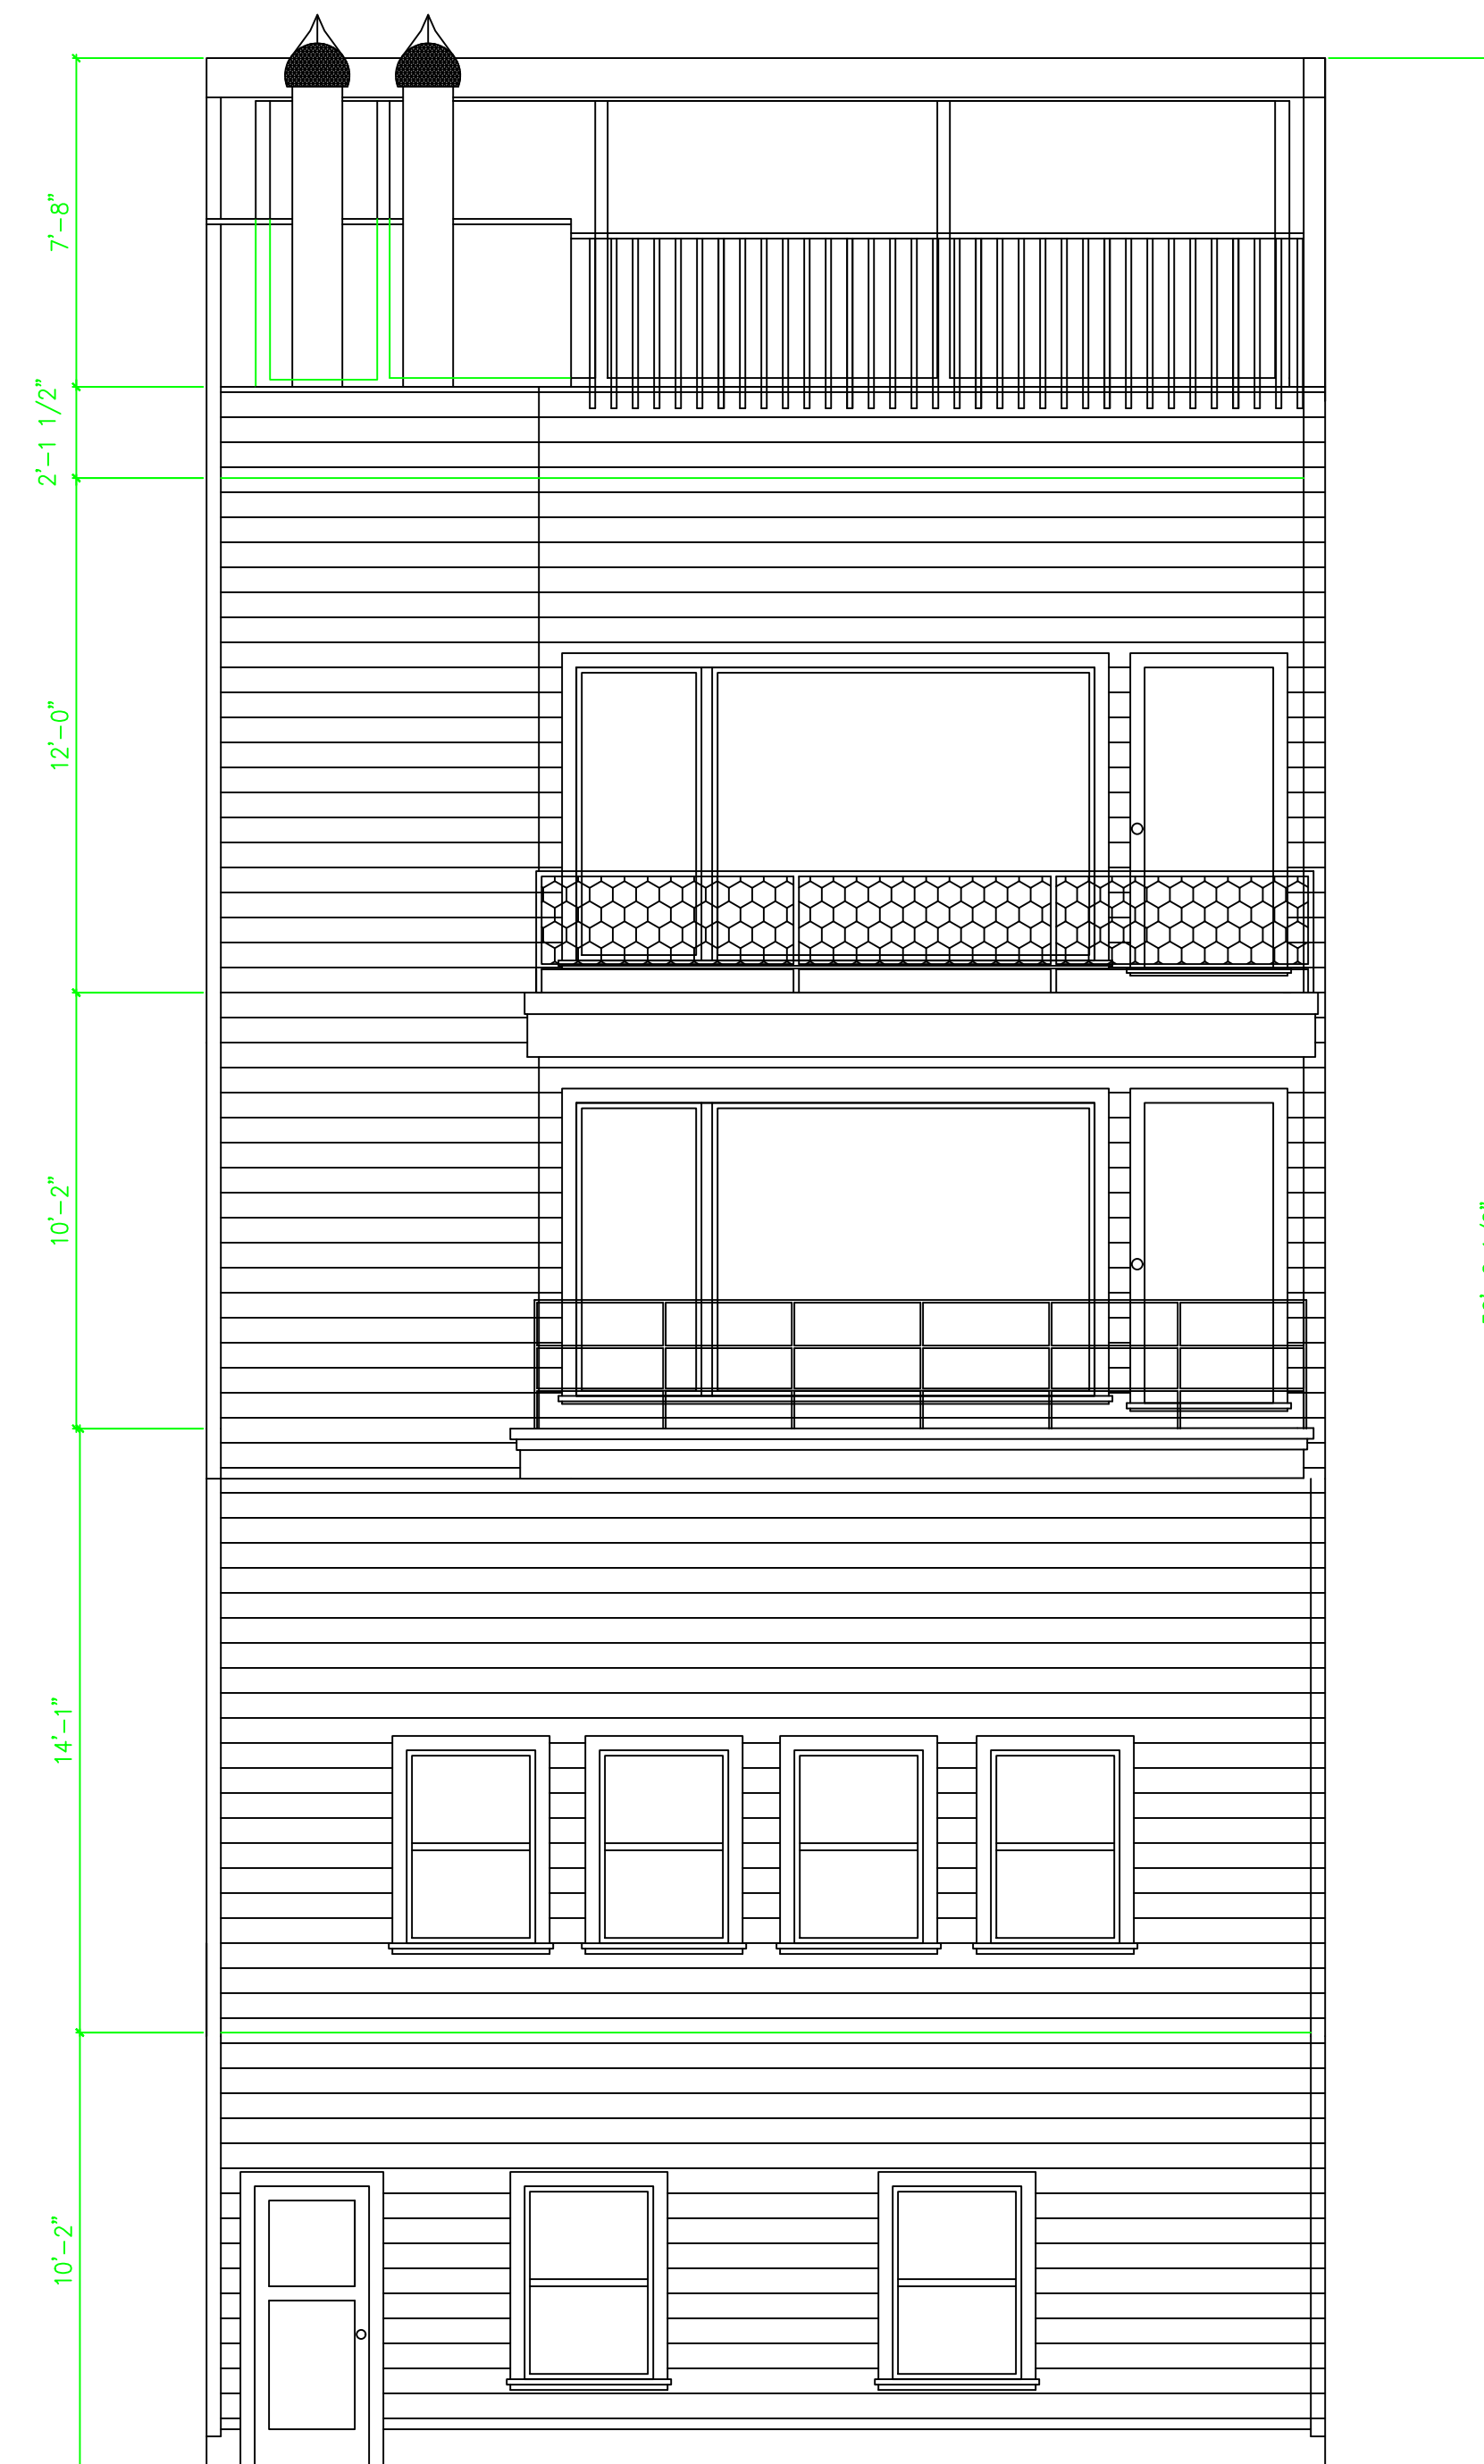

NORTH ELEVATION – FROM BACK YARD

ELEVATIONS
SCALE: 1/4"=1'-0"

Revision History

	AS-BUILT
	PRELIMINARY DESIGN
	DESIGN
	PERMIT SET
①	PLAN REVIEW COMMENTS
②	PLAN REVIEW COMMENTS

REMODEL & ADDITION

OWNER:

Drawing By:

Chris Klimen

klimen@att.net

PH: 510.928.1359

Peter Christopher Klimen
DIGITALLY SIGNED BY PETER CHRISTOPHER KLIMEN
EMAIL: KLIMEN@ATT.NET DATE: 000000

AS-BUILT
ELEVATIONS


AB7



EAST ELEVATION – VIEW FROM EAST

ELEVATIONS
 SCALE: 1/4"=1'-0"

Revision History	
	AS-BUILT
	PRELIMINARY DESIGN
	DESIGN
	PERMIT SET
①	PLAN REVIEW COMMENTS
②	PLAN REVIEW COMMENTS

 

REMODEL & ADDITION	OWNER:
--------------------	--------

Drawing By:
 Chris Klimen
 klimen@att.net
 PH: 510.928.1359

Peter Christopher Klimen
DIGITALLY SIGNED BY PETER CHRISTOPHER KLIMEN
 EMAIL: KLIMEN@ATT.NET DATE: 000000

AS-BUILT
 ELEVATIONS

AB8